


T. 27 & 28 S., R. 6 W., W.M.

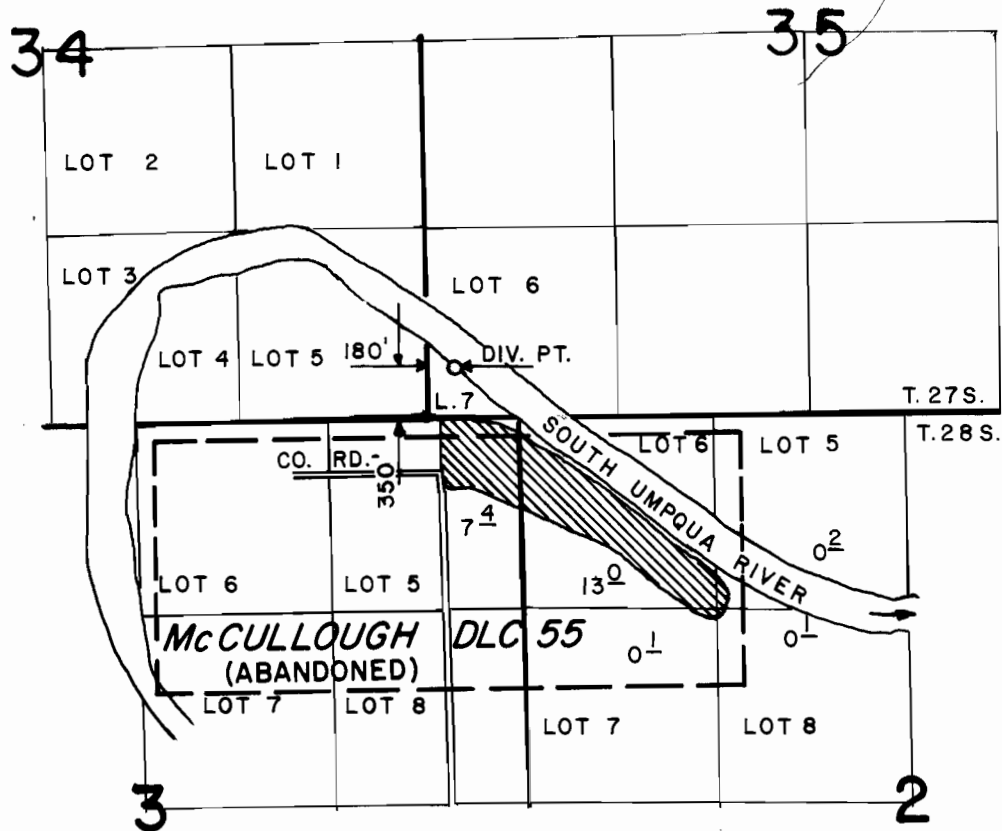

SCALE: 4" = 1 MILE

FINAL PROOF SURVEY UNDER

Application No. 68161..... Permit No. 48972.....
IN NAME OF

FLOYD BOYD

Surveyed MAY 5... 1987., by J. M. SCHMORDE