


T. 35 S., R. 6 W., W.M.

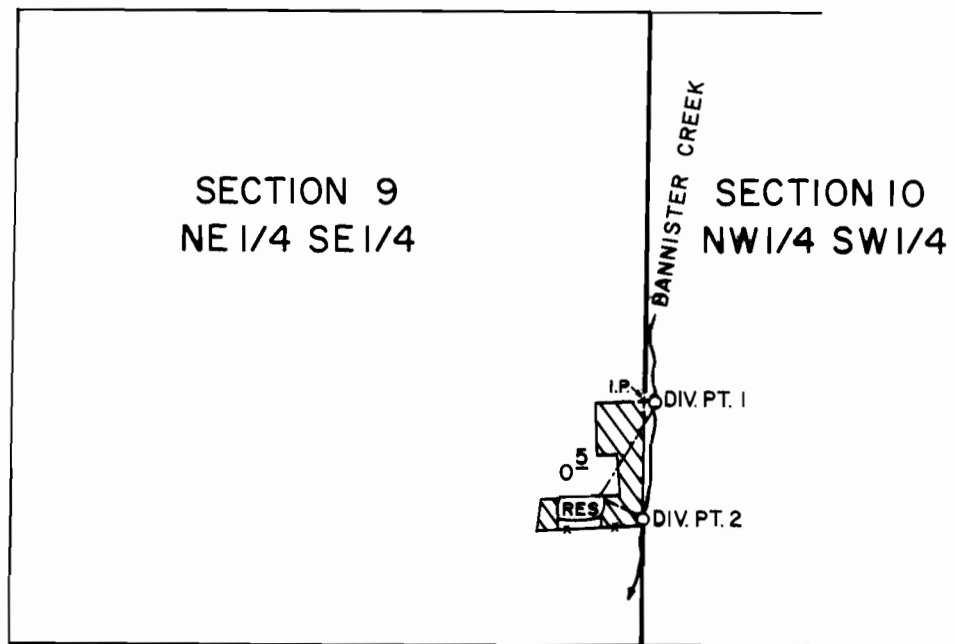

DIV. PTS LOC.: 810' S. & 20' E., 1060' S. BOTH FROM E. 1/4 CORNER
SECTION 9.

SCALE: 1" = 400'

FINAL PROOF SURVEY
UNDER

R-68208 R-10052

Application No. 68209 Permit No. 48997
IN NAME OF

RICHARD E. VAN AMBERG

Surveyed MAY 4 1989, by B. S. JAMES

8-10-89
PTS