


T. 1S., R. 3W., W.M.

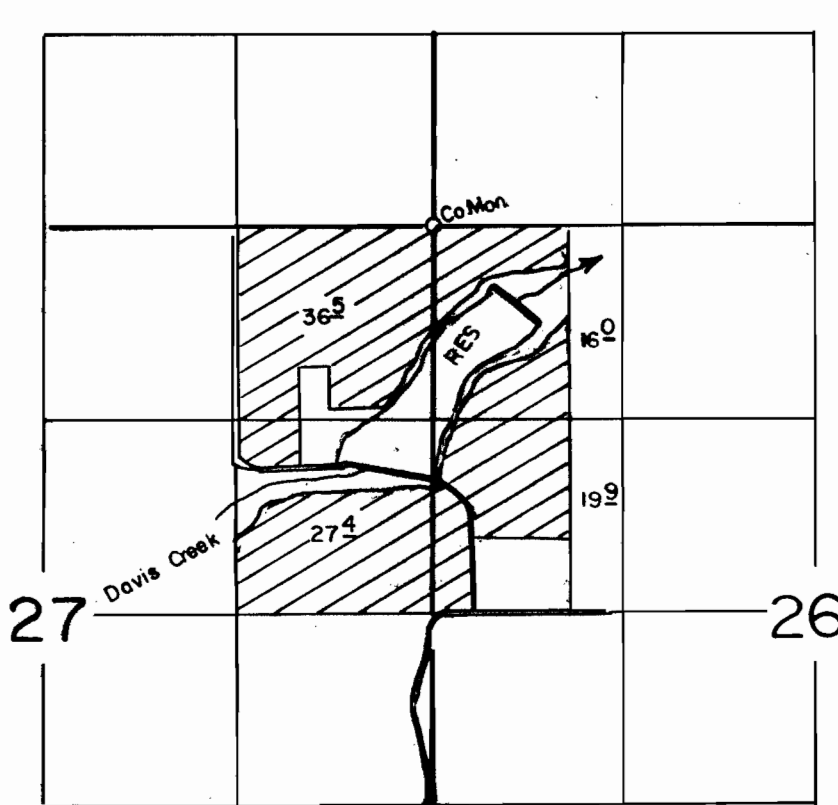

DIV PT LOCATED 560'S & 550'E FROM NW CORNER SECTION 26

SCALE: 1"= 1320'

**FINAL PROOF SURVEY**  
UNDER

R-68323

R-10505

Application No. 68324..... Permit No. 49375.....

IN NAME OF

..OREGON..GARDEN..PRODUCTS, INC..

Surveyed JULY..12.. 1989., by J.M. WARREN.....