


T. 1S., R. 3W., W.M.

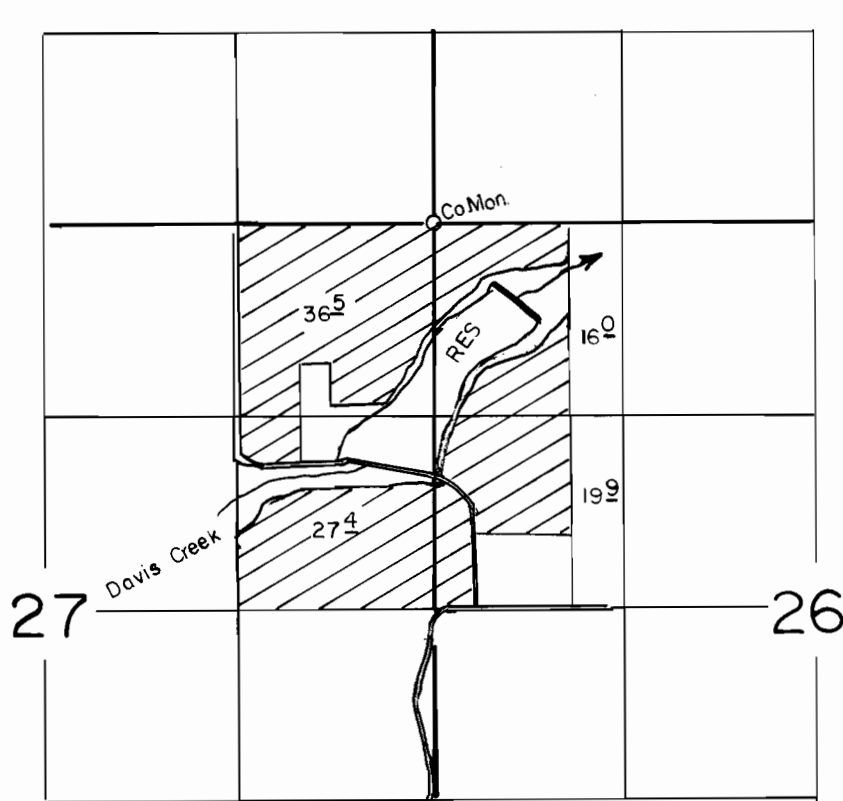

DIV PT LOCATED 560'S & 550'E FROM NW CORNER SECTION 26

SCALE: 1"=1320'

**FINAL PROOF SURVEY**  
UNDER

R-68323

R-10505

Application No. 68324..... Permit No. 49375.....

IN NAME OF

OREGON GARDEN PRODUCTS, INC.

Surveyed JULY 12, 1989., by J.M. WARREN.....