


T. 4N., R 9W., W.M.

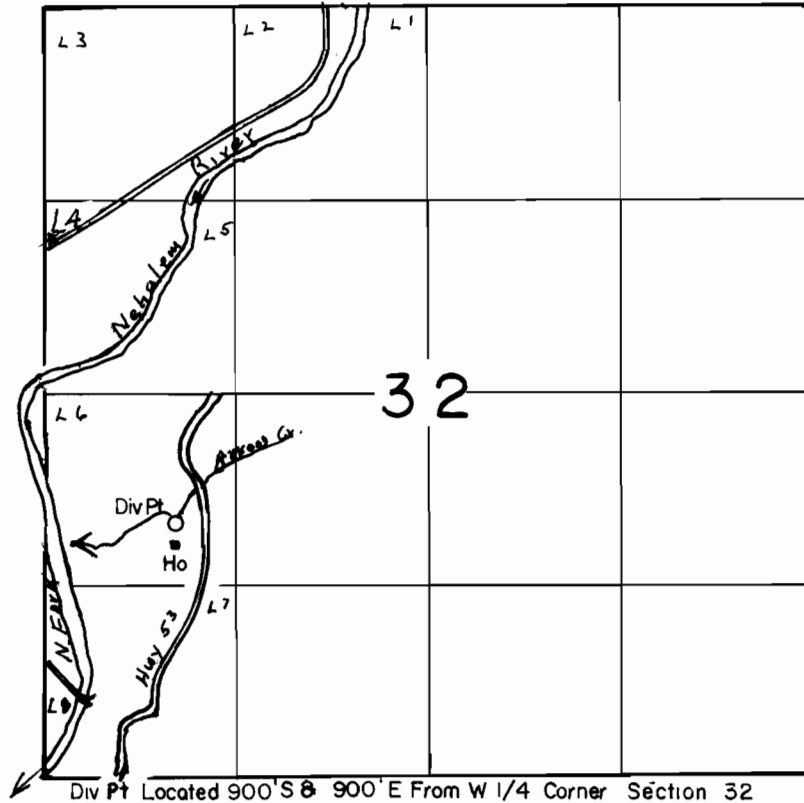

SCALE: 1" = 1320'

FINAL PROOF SURVEY
UNDER

Application No. 68326 Permit No. 49376
IN NAME OF

SAMUEL E. & MARJORIE STANFORD

Surveyed JUNE 19 1989, by I.M. WARREN