




T. 3 S., R. 1 W., W.M.

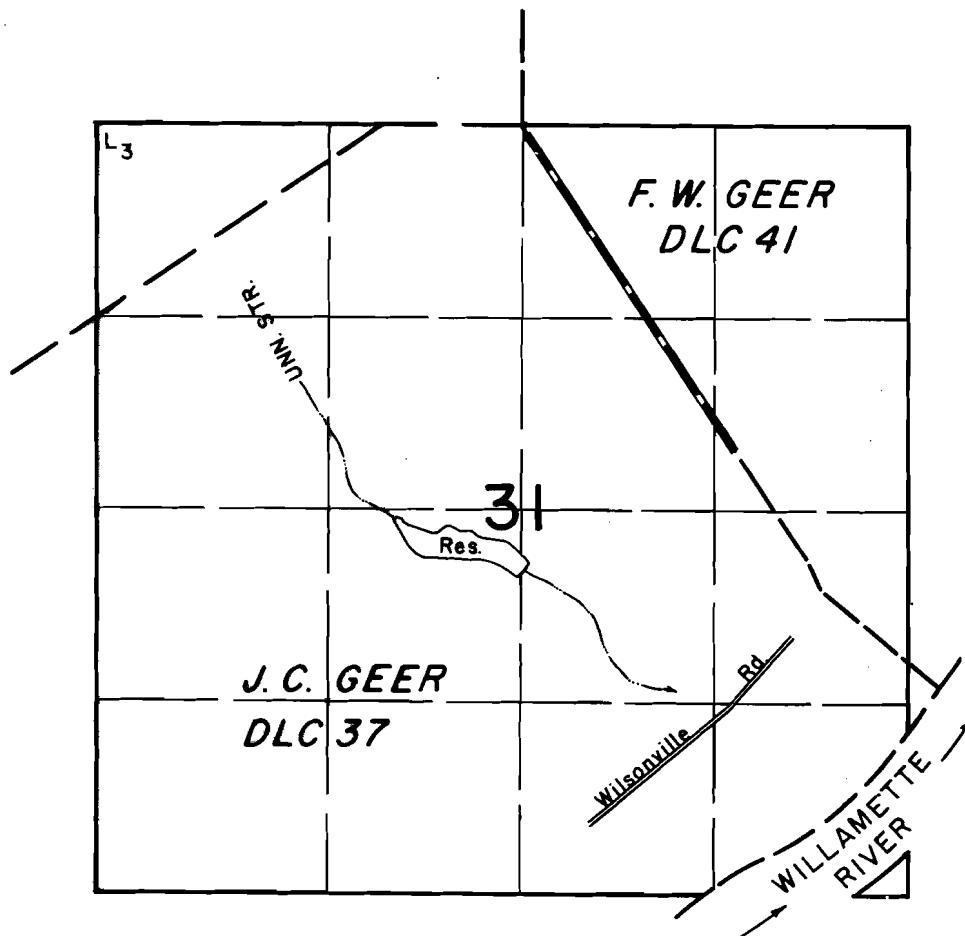

DAM LOC.: 3070' S. & 20' E. FROM N1/4 CORNER SECTION 31.

SCALE: 1" = 1320'

FINAL PROOF SURVEY UNDER

R-68263

R-10509

Application No. 68360.. Permit No. 49403....

IN NAME OF

WENDALL B. & KATHY S. LILE.

Surveyed JULY 15 1986, by T. M. WARREN..

6-30-89
41005-278-229D

fx