


T.8S., R.6W., W.M.

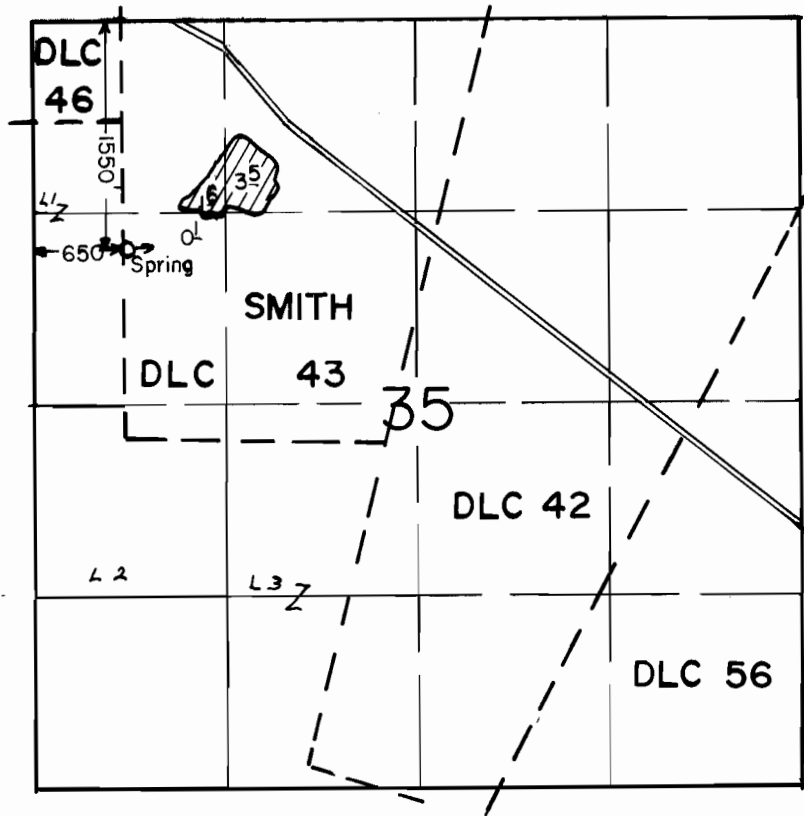

SCALE: 1" = 1320'

**FINAL PROOF SURVEY**  
UNDER

Application No. 68462..... Permit No. 49445.....  
IN NAME OF

**DONALD A. RENC**

Surveyed JUNE. 15..... 1989., by T.M. WARREN.....