


T. 8N., R. 10W., W M

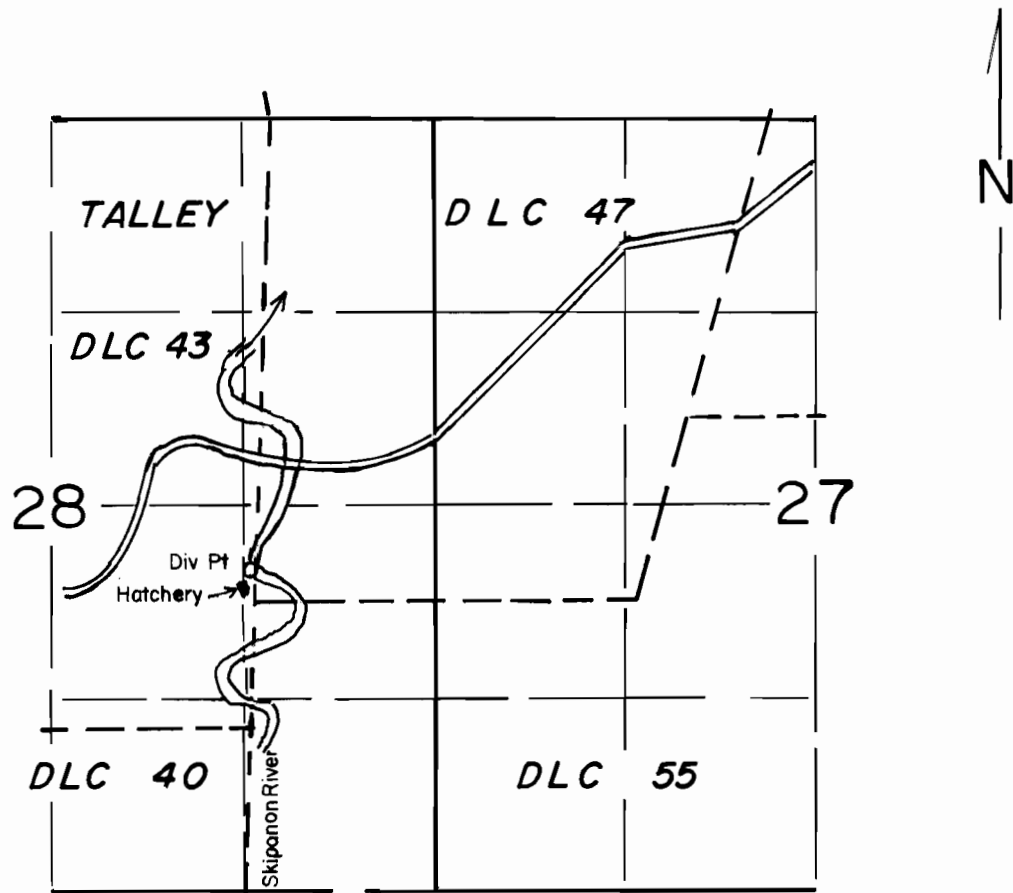

Div. Pt. Located 450' S. & 1240' W. From E. 1/4 Corner Section 28

SCALE: 1" = 1320'

FINAL PROOF SURVEY
UNDER

Application No. 68.774... Permit No. 49.936...
IN NAME OF

SCHOOL DISTRICT NO. 30

Surveyed JUNE 19... 1989., by I.M. WARREN