


T.9S., R.6W., W.M.

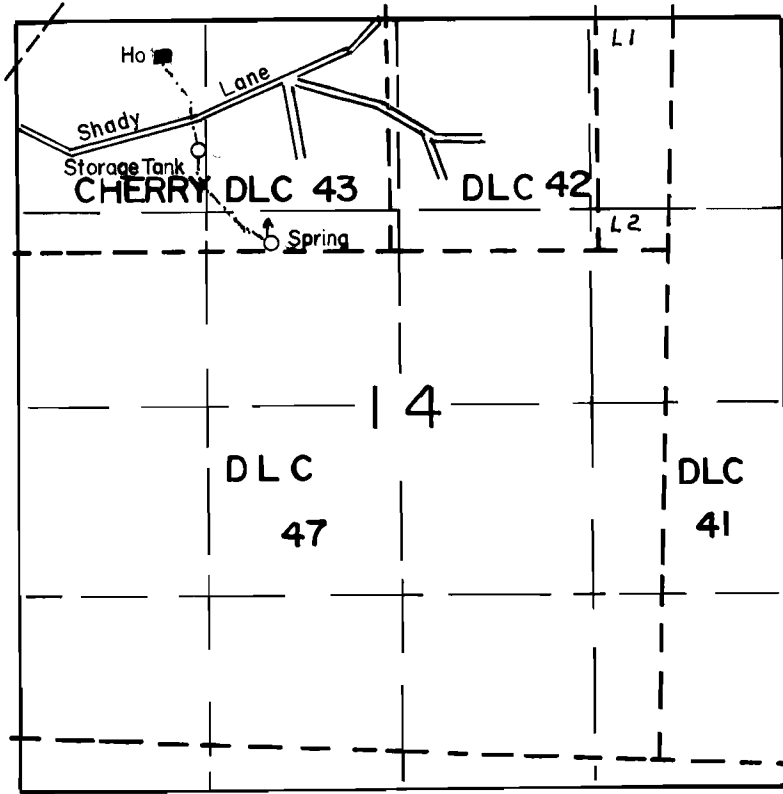

Spring Located 50' N & 820' W From SE Corner DLC 43, Section 14

SCALE: 1" = 1320'

**FINAL PROOF SURVEY
UNDER**

Application No. 68804..... Permit No. 49903.....
IN NAME OF

.....JON & LINDA DRAKE.....

Surveyed MAY 19... 1989., by I.M. WARREN.....