


T.6S., R.6W., W.M.

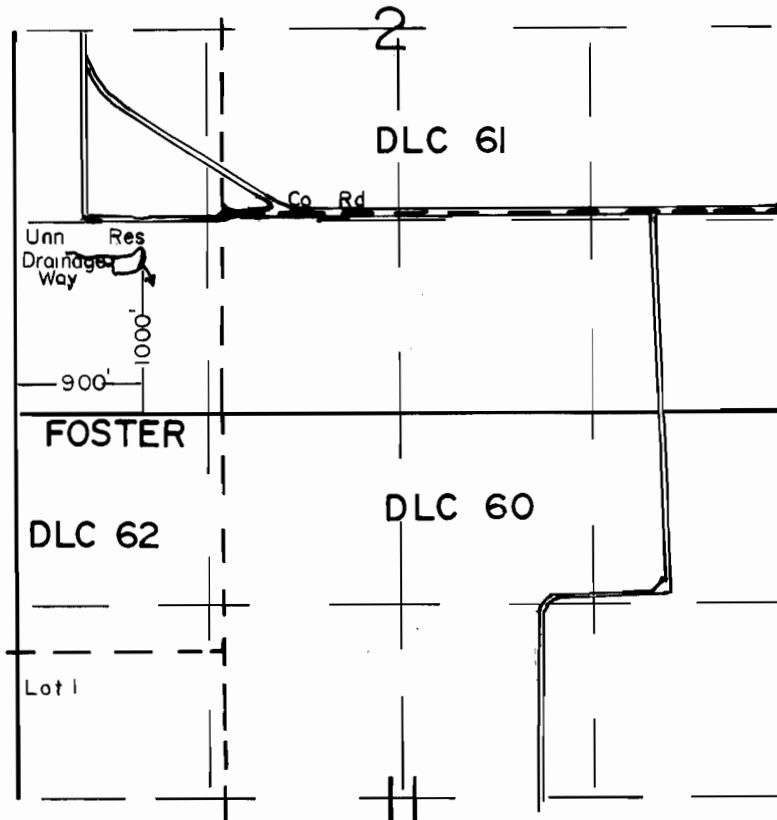

SCALE: 1" = 1320'

FINAL PROOF SURVEY
UNDER

Application No. R-68825 Permit No. R-10811.....
IN NAME OF

.....WILLIAM.....JARVIS.....

Surveyed JULY 6..... 1989., by I.M. WARREN.....