


R-9024

RECEIVED

AUG 25 1983

WATER RESOURCES DEPT.
SALEM, OREGON

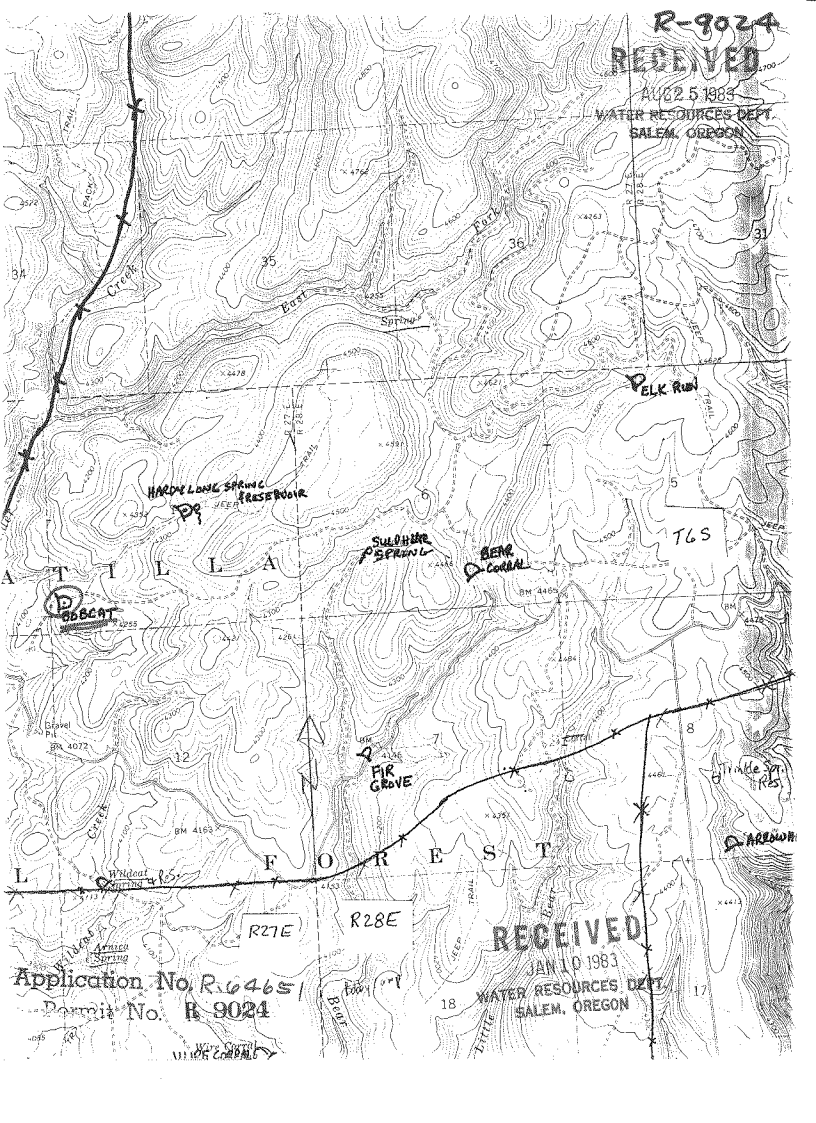

Application No. R-6465
Permit No. R-9024

RECEIVED

JAN 10 1983

18 WATER RESOURCES DEPT.
SALEM, OREGON

WATER CONTROL
UNIT CORRAL