


1976

Scale 1/2" = 1 Mile

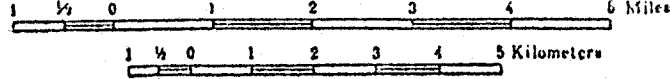

1:126,720
LEGEND

XX ALLOTMENT
BOUNDARY

SWALE

A LONGVIEW

RECEIVED

AUG 25 1983

WATER RESOURCES DEPT
SALEM, OREGON

Application No. R-64667

Permit No. R 9032

RECEIVED

JAN 10 1985


WATER RESOURCES DEPT
SALEM, OREGON

R. 27 E.

R. 28 E.

R. 29 E.

TOWNSHIP 6S, RANGE 28E, SECTION 21, W.M.

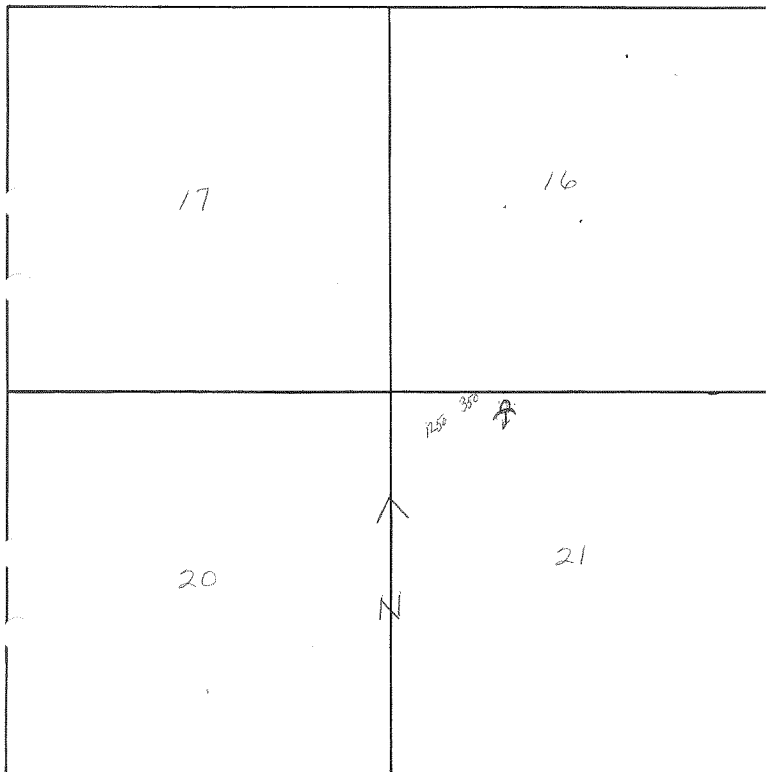

RECEIVED

NAME LOMBVIEW RES.

COUNTY MORROW

JAN 10 1983

Application No. R-64667

RECEIVED

WATER RESOURCES DEPT.
SALEM, OREGON

Permit No.

R 9032

21

AUG 25 1983
WATER RESOURCES DEPT.
SALEM, OREGON