


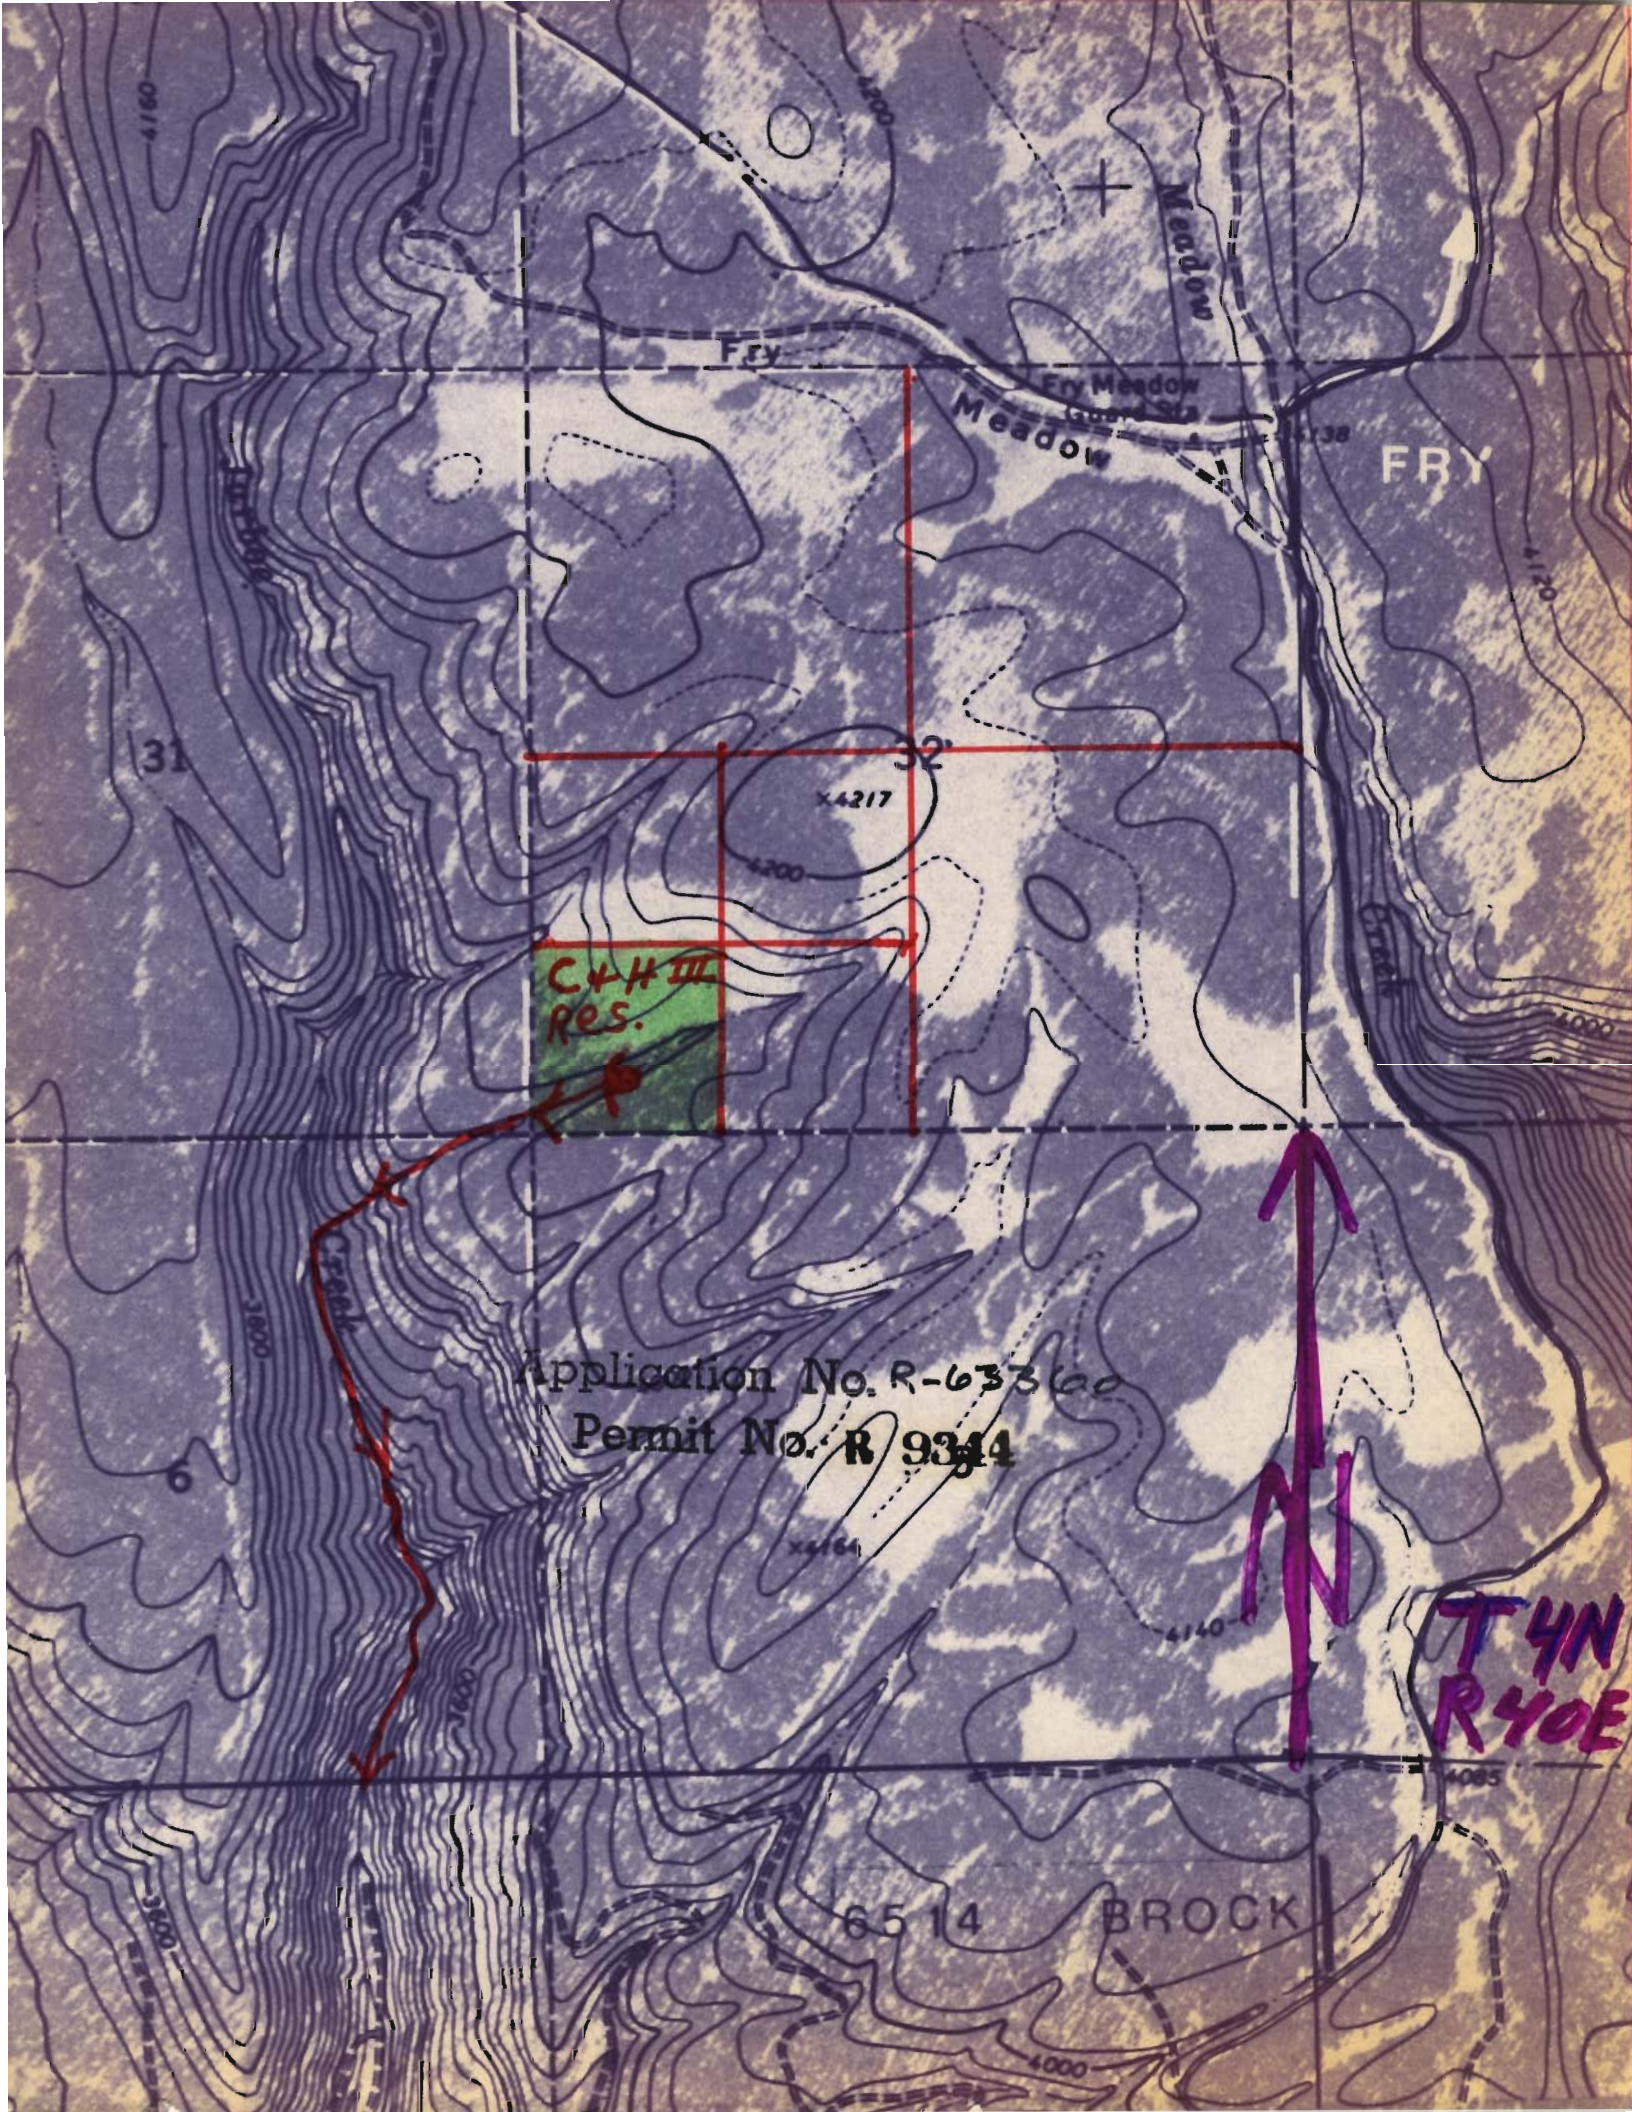

FRY

C+H III
Res.

Application No. R-63360
Permit No. R 9344

T4N
R40E

BROCK