

15

14

Application No. R64429
Permit No. R 9606

22

23

NAME

Walker Spring Reservoir

COUNTY

Wheeler


RECEIVED

OCT 11 1982

WATER RESOURCES DEPT.
SALEM, OREGON



R-9606
2082

Application No. R64429
Permit No. R 9606

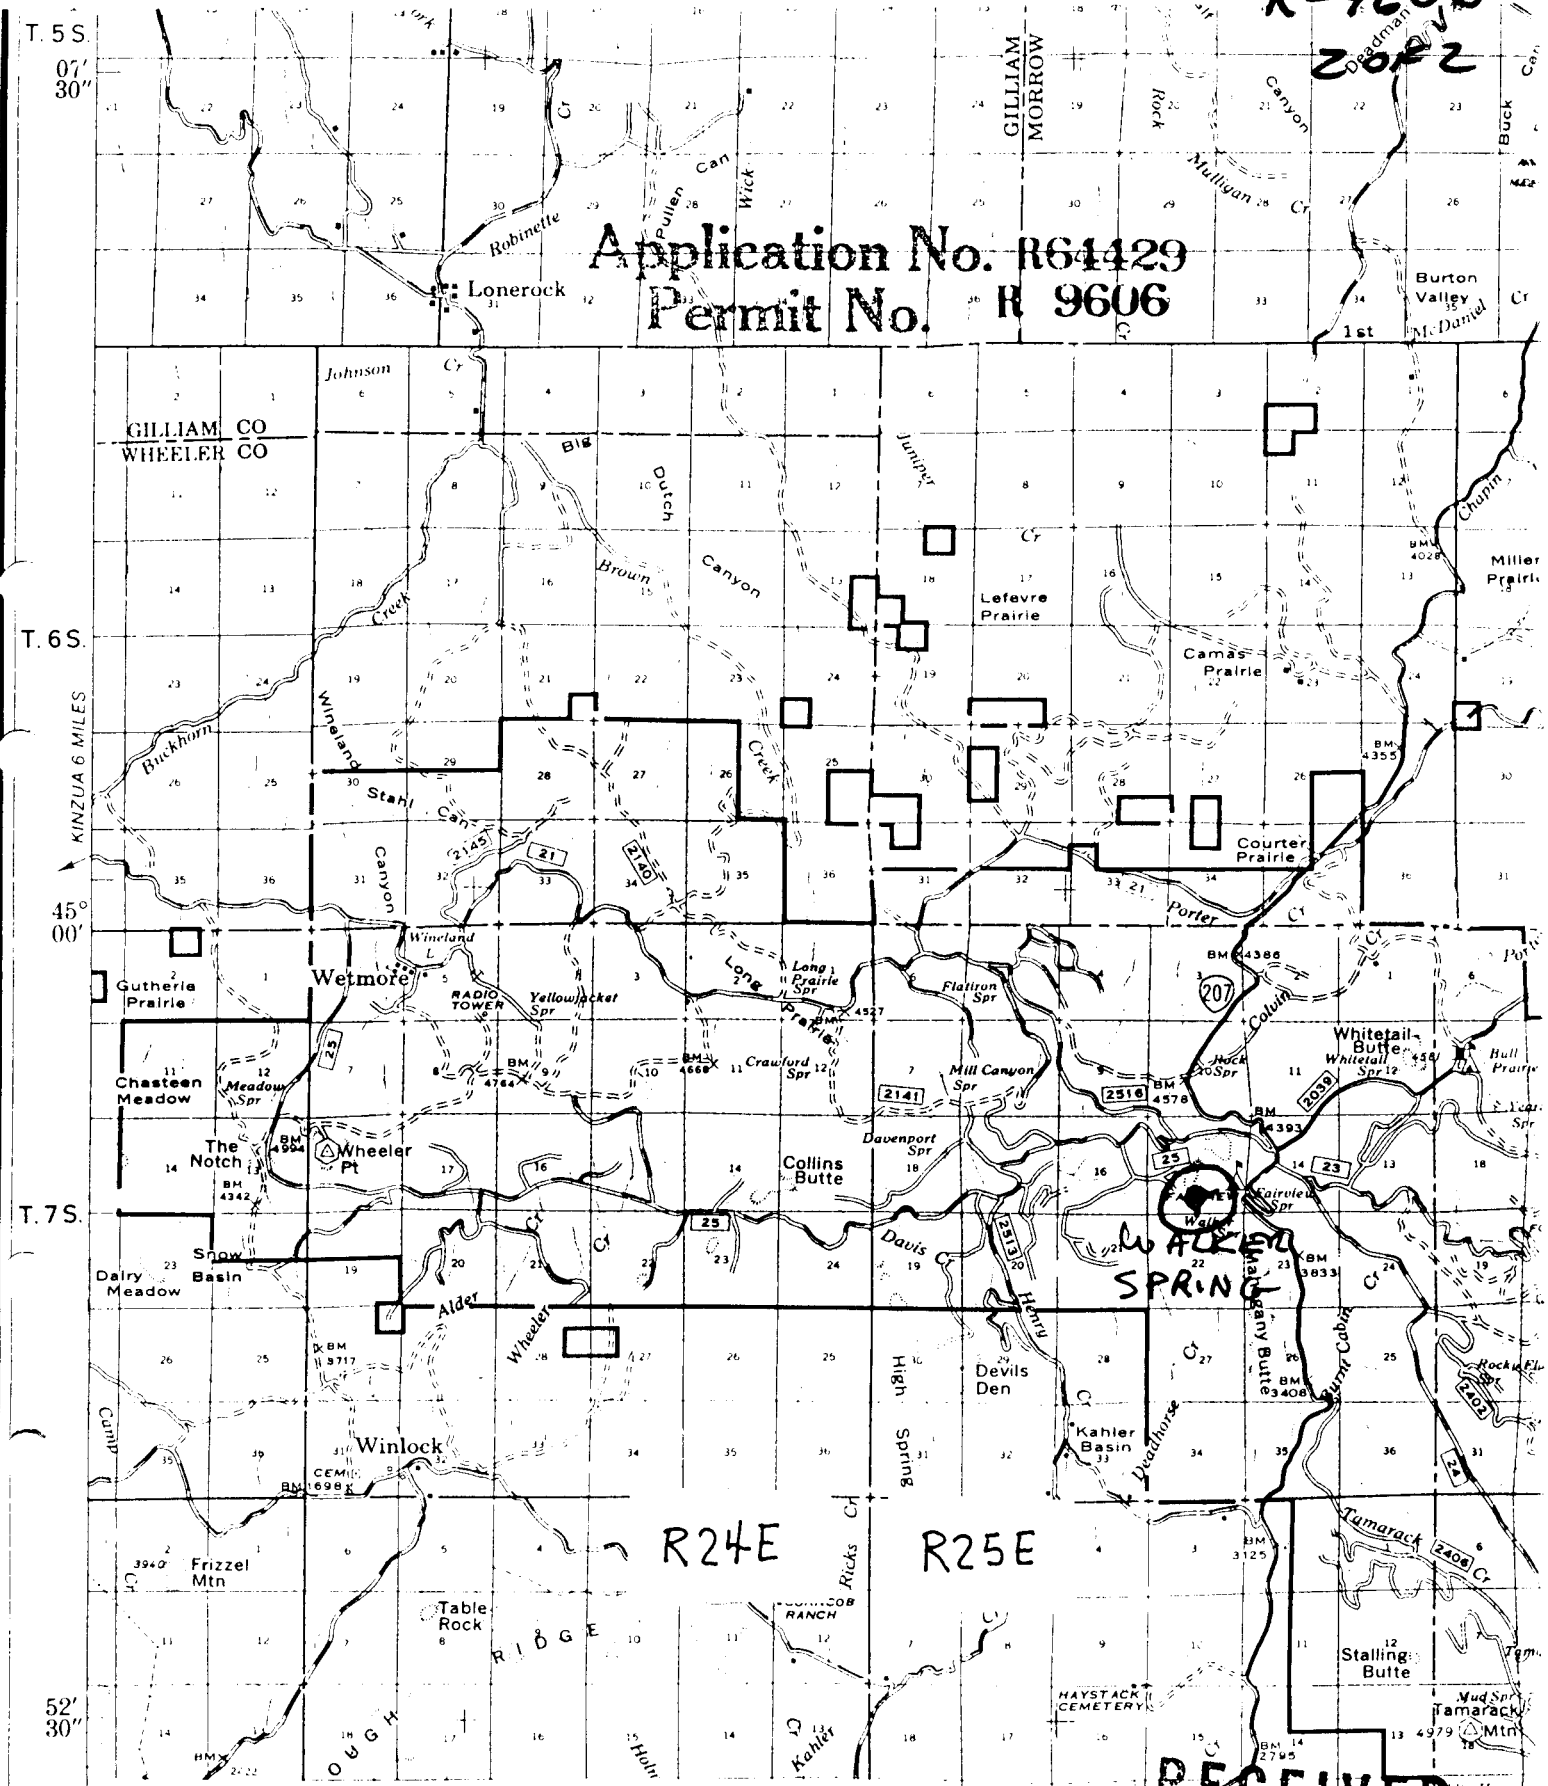

T.8S.

1976

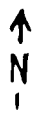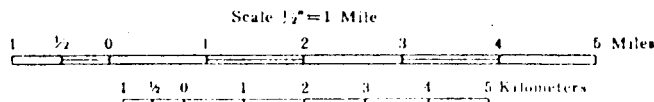

LEGEND
1:126,720
COLLINS BUTTE

ALLOTMENT
BOUNDARY

RECEIVED
OCT 11 1982
WATER RESOURCES DEPT.
SALEM, OREGON