

TOWNSHIP

75

RANGE

25

SECTION

R-9607

1012
63381

21

22

Application No. R64430
Permit No. R 9607



28

27

NAME

West Hadhorse Res

COUNTY

Wheeler


RECEIVED

OCT 11 1982

WATER RESOURCES DEPT.
SALEM, OREGON

T. 8 S.

Application No.	R64430
Permit No.	R 9607

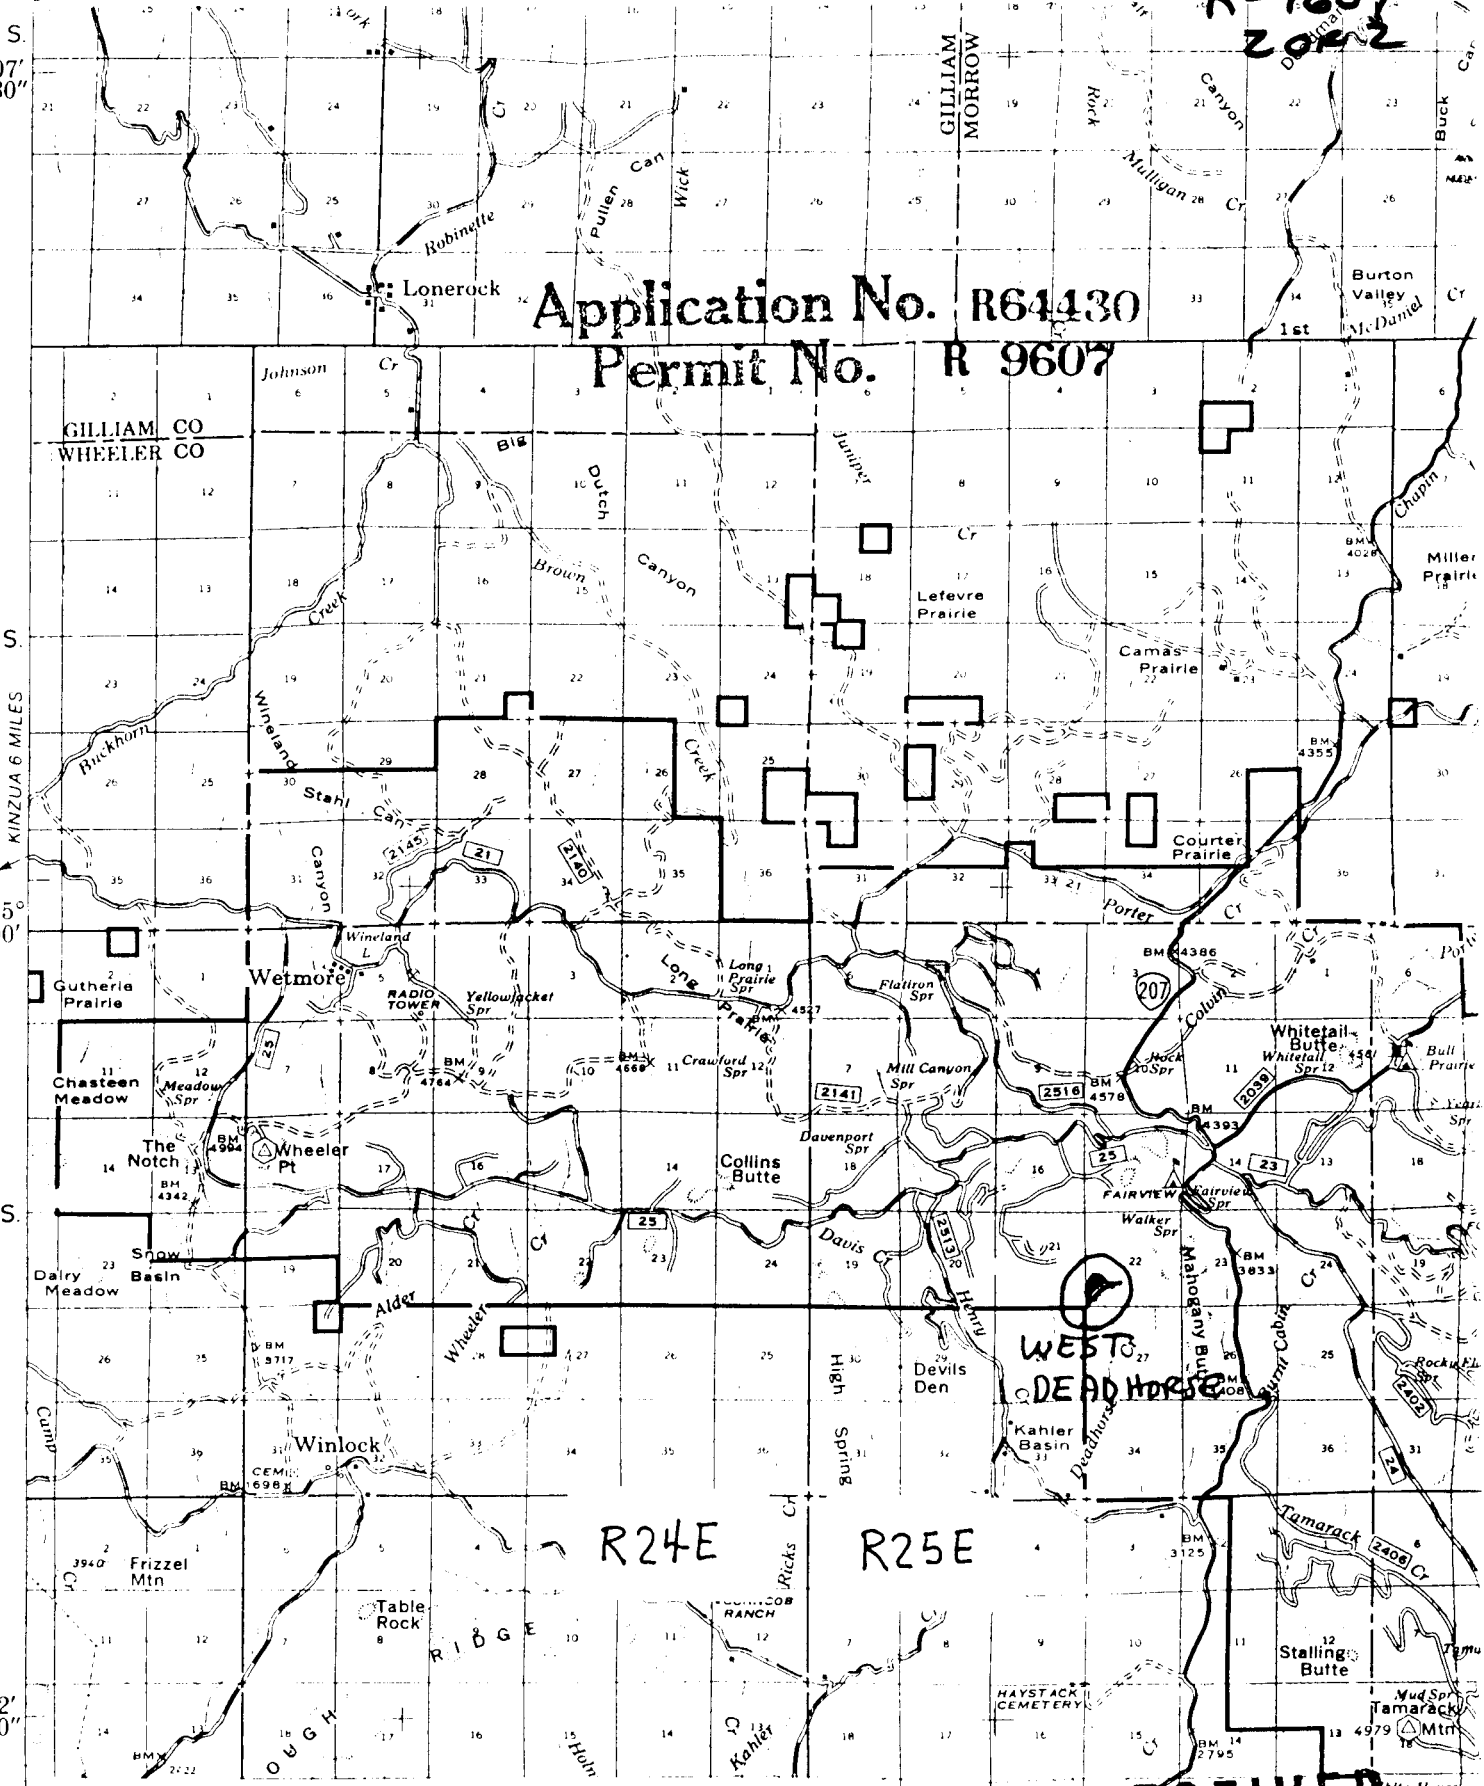


R24E

R25E

WEST 27
DEAD HORSE

1976

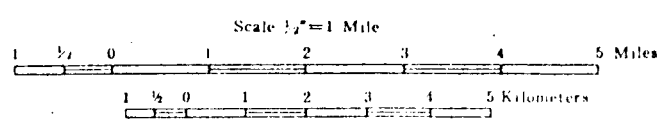

↑
N
,

1.126.720
LEGEND

~~XXXX~~ ALLOTMENT BOUNDARY

C. COLLINS BUTTE

RECEIVED

OCT 11 1982

WATER RESOURCES DEPT.
SALEM, OREGON