
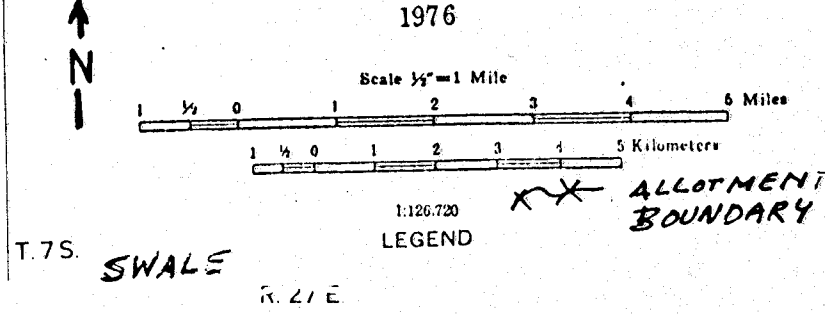


R-9610
1 OF 2

Application No. R64431
Permit No. R-9610

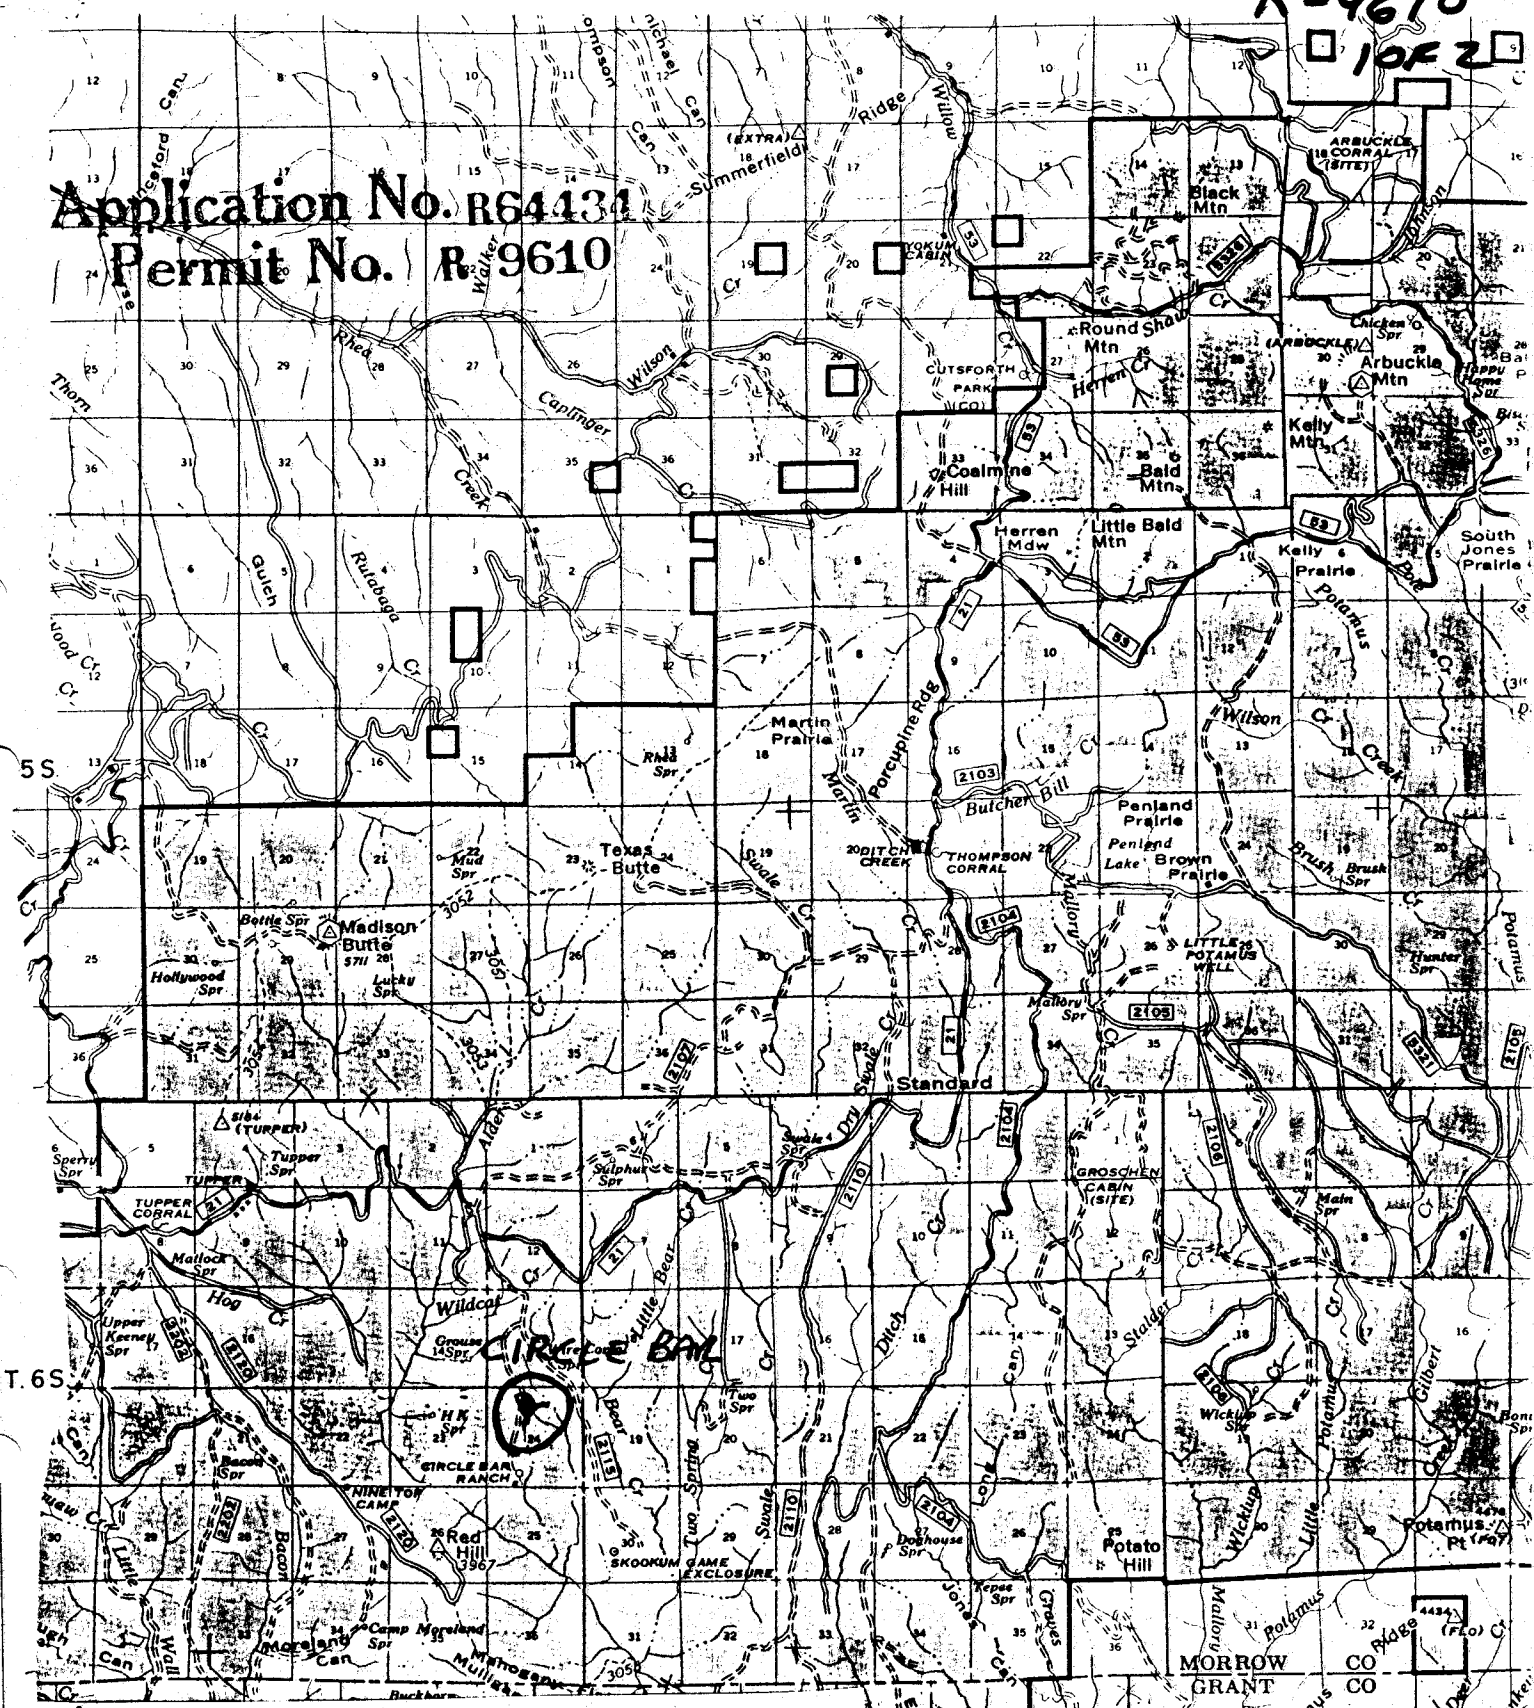

RECEIVED

OCT 11 1982

WATER RESOURCES DEPT.
SALEM, OREGON

R. 28 E. R. 29 E.

R-9610
2 OF 2

TOWNSHIP 65, RANGE 27E, SECTION 24, W.M.

14

13

Application No. R64434
Permit No. R 9610

1070'
2300'

23

24

NAME Circle Bar Res

COUNTY Jefferson

RECEIVED
OCT 11 1982
WATER RESOURCES DEPT.
SALEM, OREGON