


R-9612
10E2

Application No. R64436
Permit No. R 9612

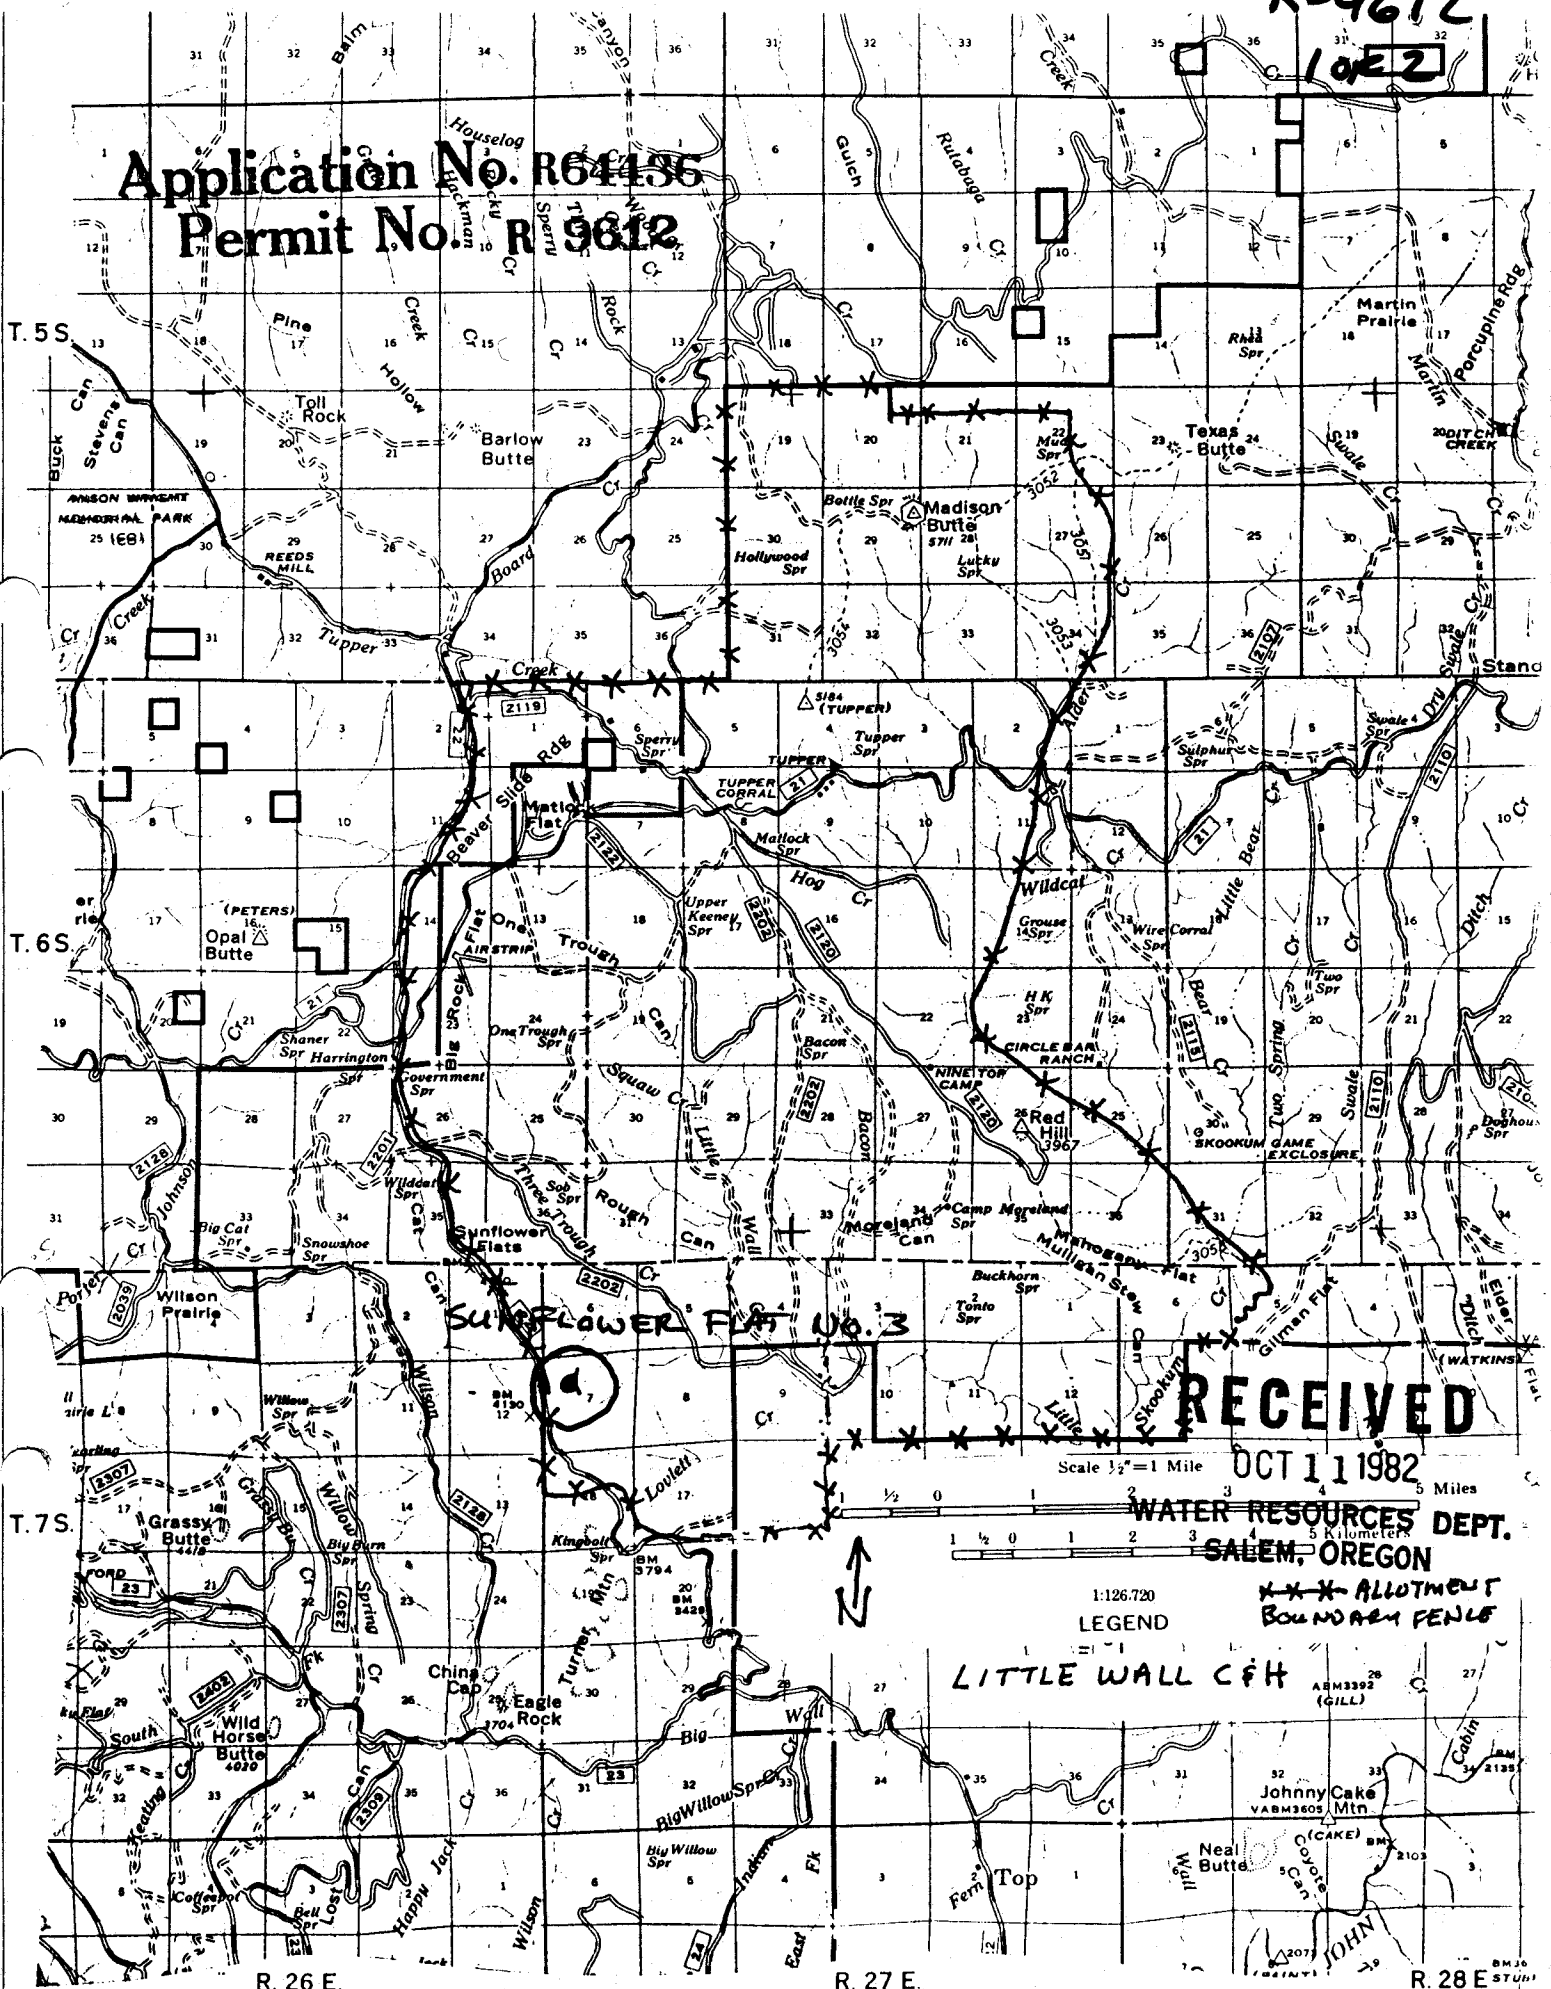

RECEIVED

OCT 11 1982

WATER RESOURCES DEPT.
SALEM, OREGON

*** ALLOTMENT
BOUNDARY FENCE

1:126,720
LEGEND

LITTLE WALL C&H

ARM 3392
(GILL)

Johnny Cake
VABM 3605 Mtn

(CAKE) BM
2103

JOHN

R. 26 E.

R. 27 E.

R. 28 E. STU

R-9612
2023

BM 4180

T7S
R27E
section 7

CANYON

Sunflower

T7S

Sunflower

Application No. 64436
Permit No. 129612

Sunflower

BM 4130
Spr

R27E