


R-9617
1072

Application No. R-9617
Permit No. R-9617

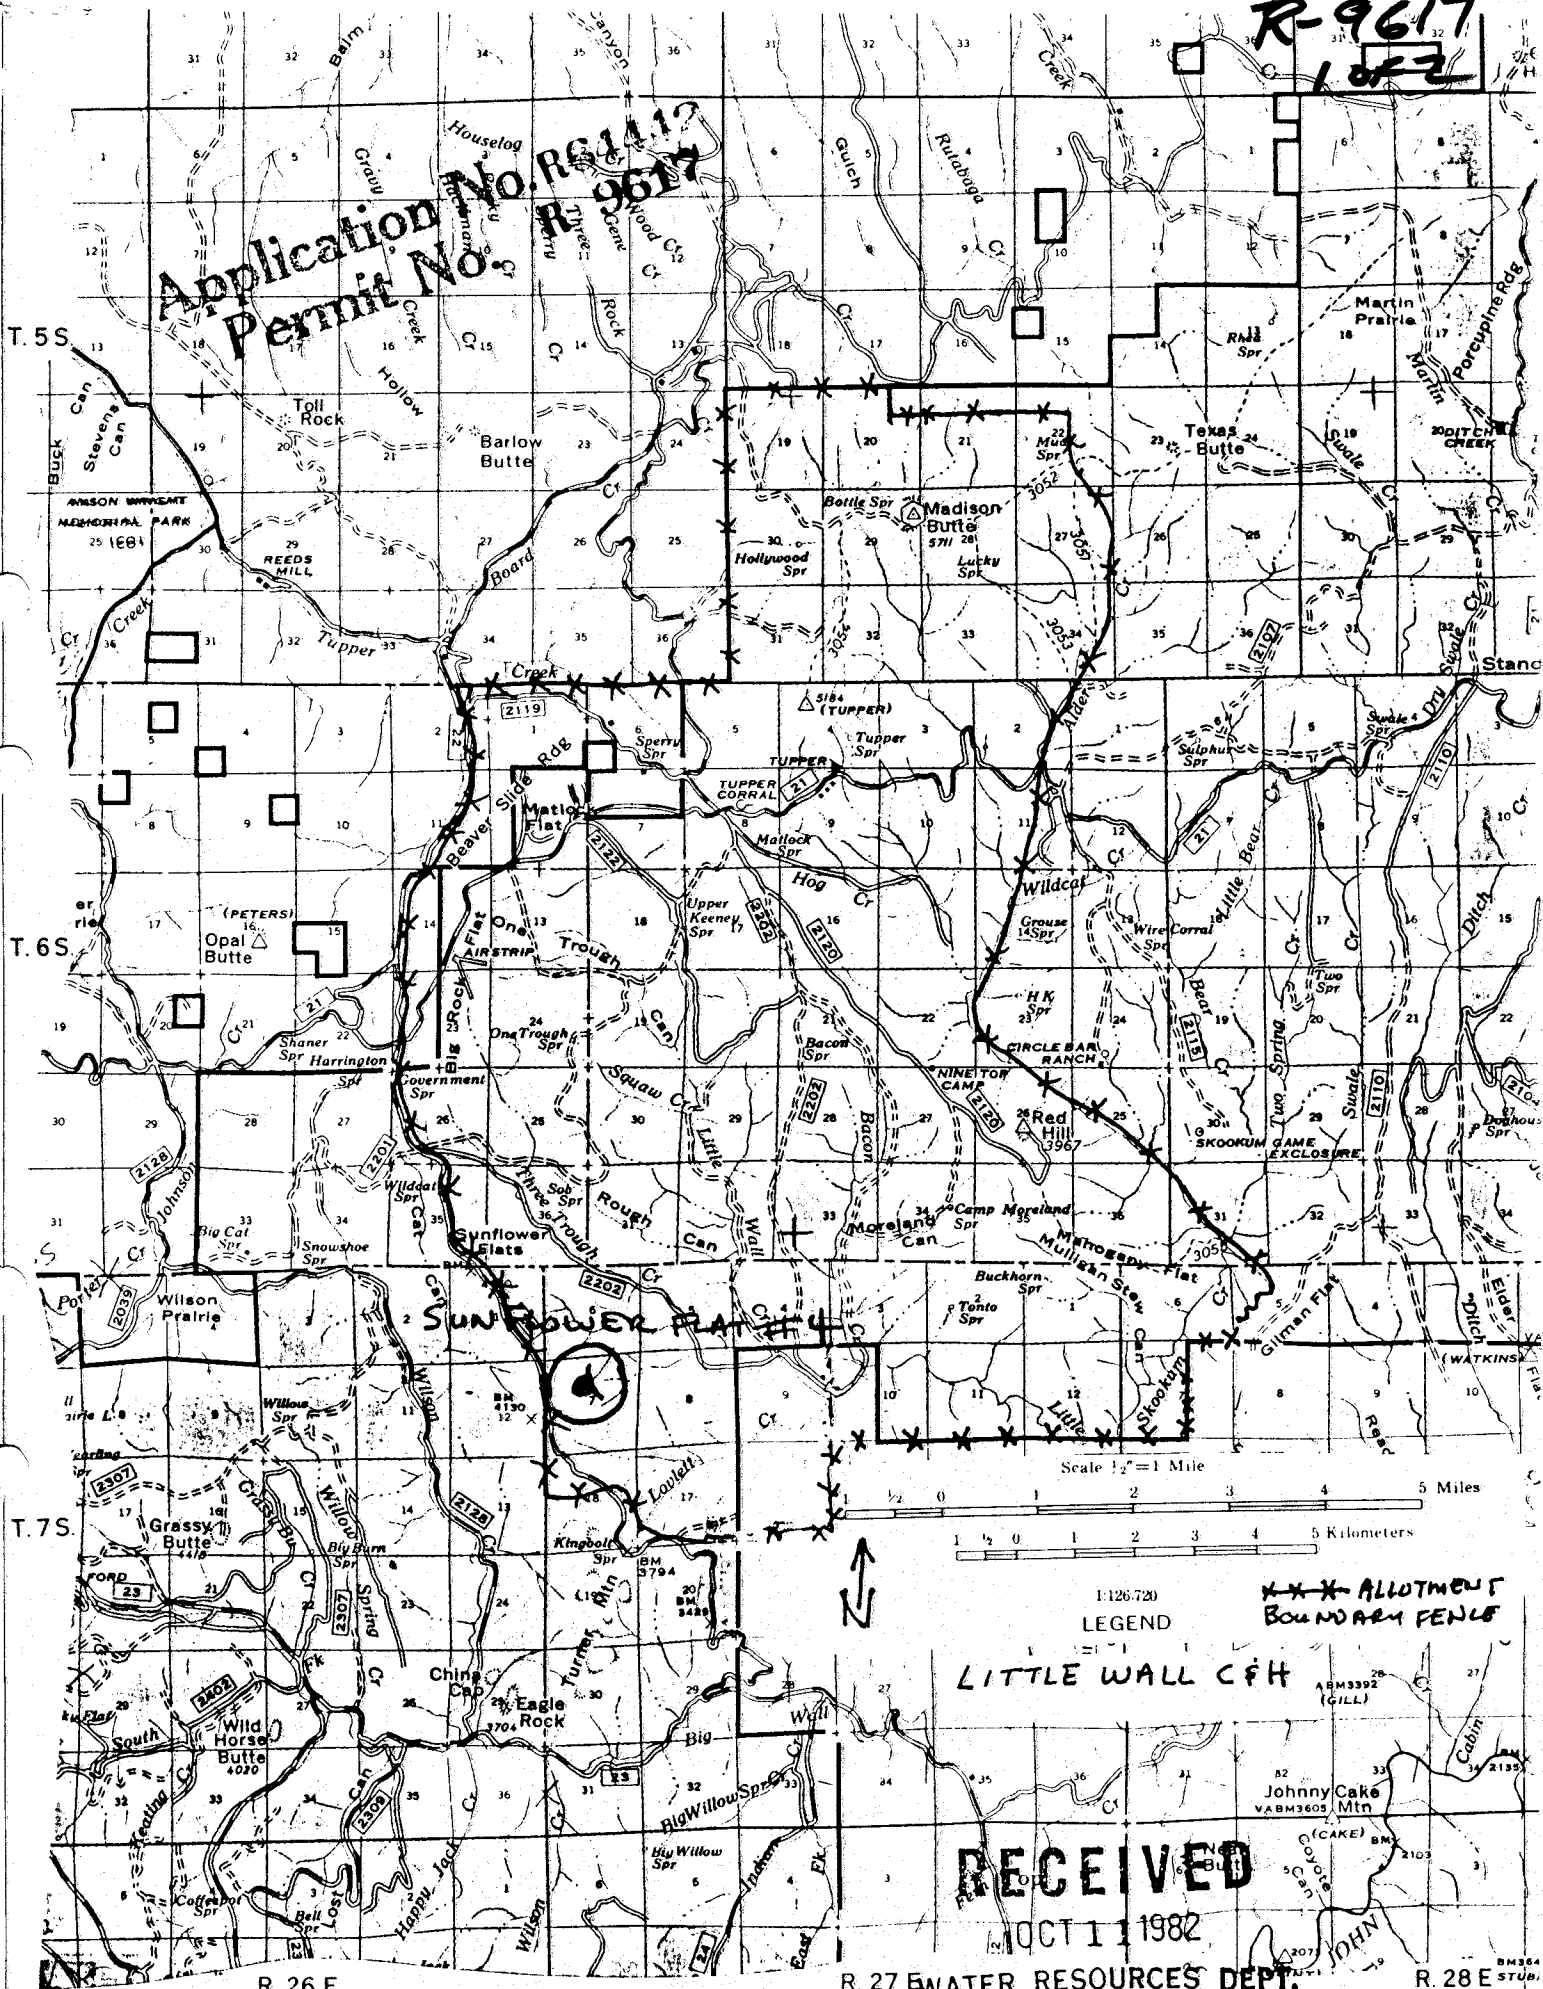

1:126,720
LEGEND
*** ALLOTMENT
BOUNDARY FENCE

LITTLE WALL C&H

RECEIVED

OCT 11 1982

WATER RESOURCES DEPT.
SALEM, OREGON

R. 26 E.

R. 28 E



RAVER Z482
CANYON

MORROW
GRANT

6

3680

775

FLOWER
No 4

Application No. R-64442
Permit No. R 9617

4000

3681

R-9617