


R-9637 63406
1 OF 2

12 Matlock


Application No. R-64462
Permit No. R 9637

Opal
R26E

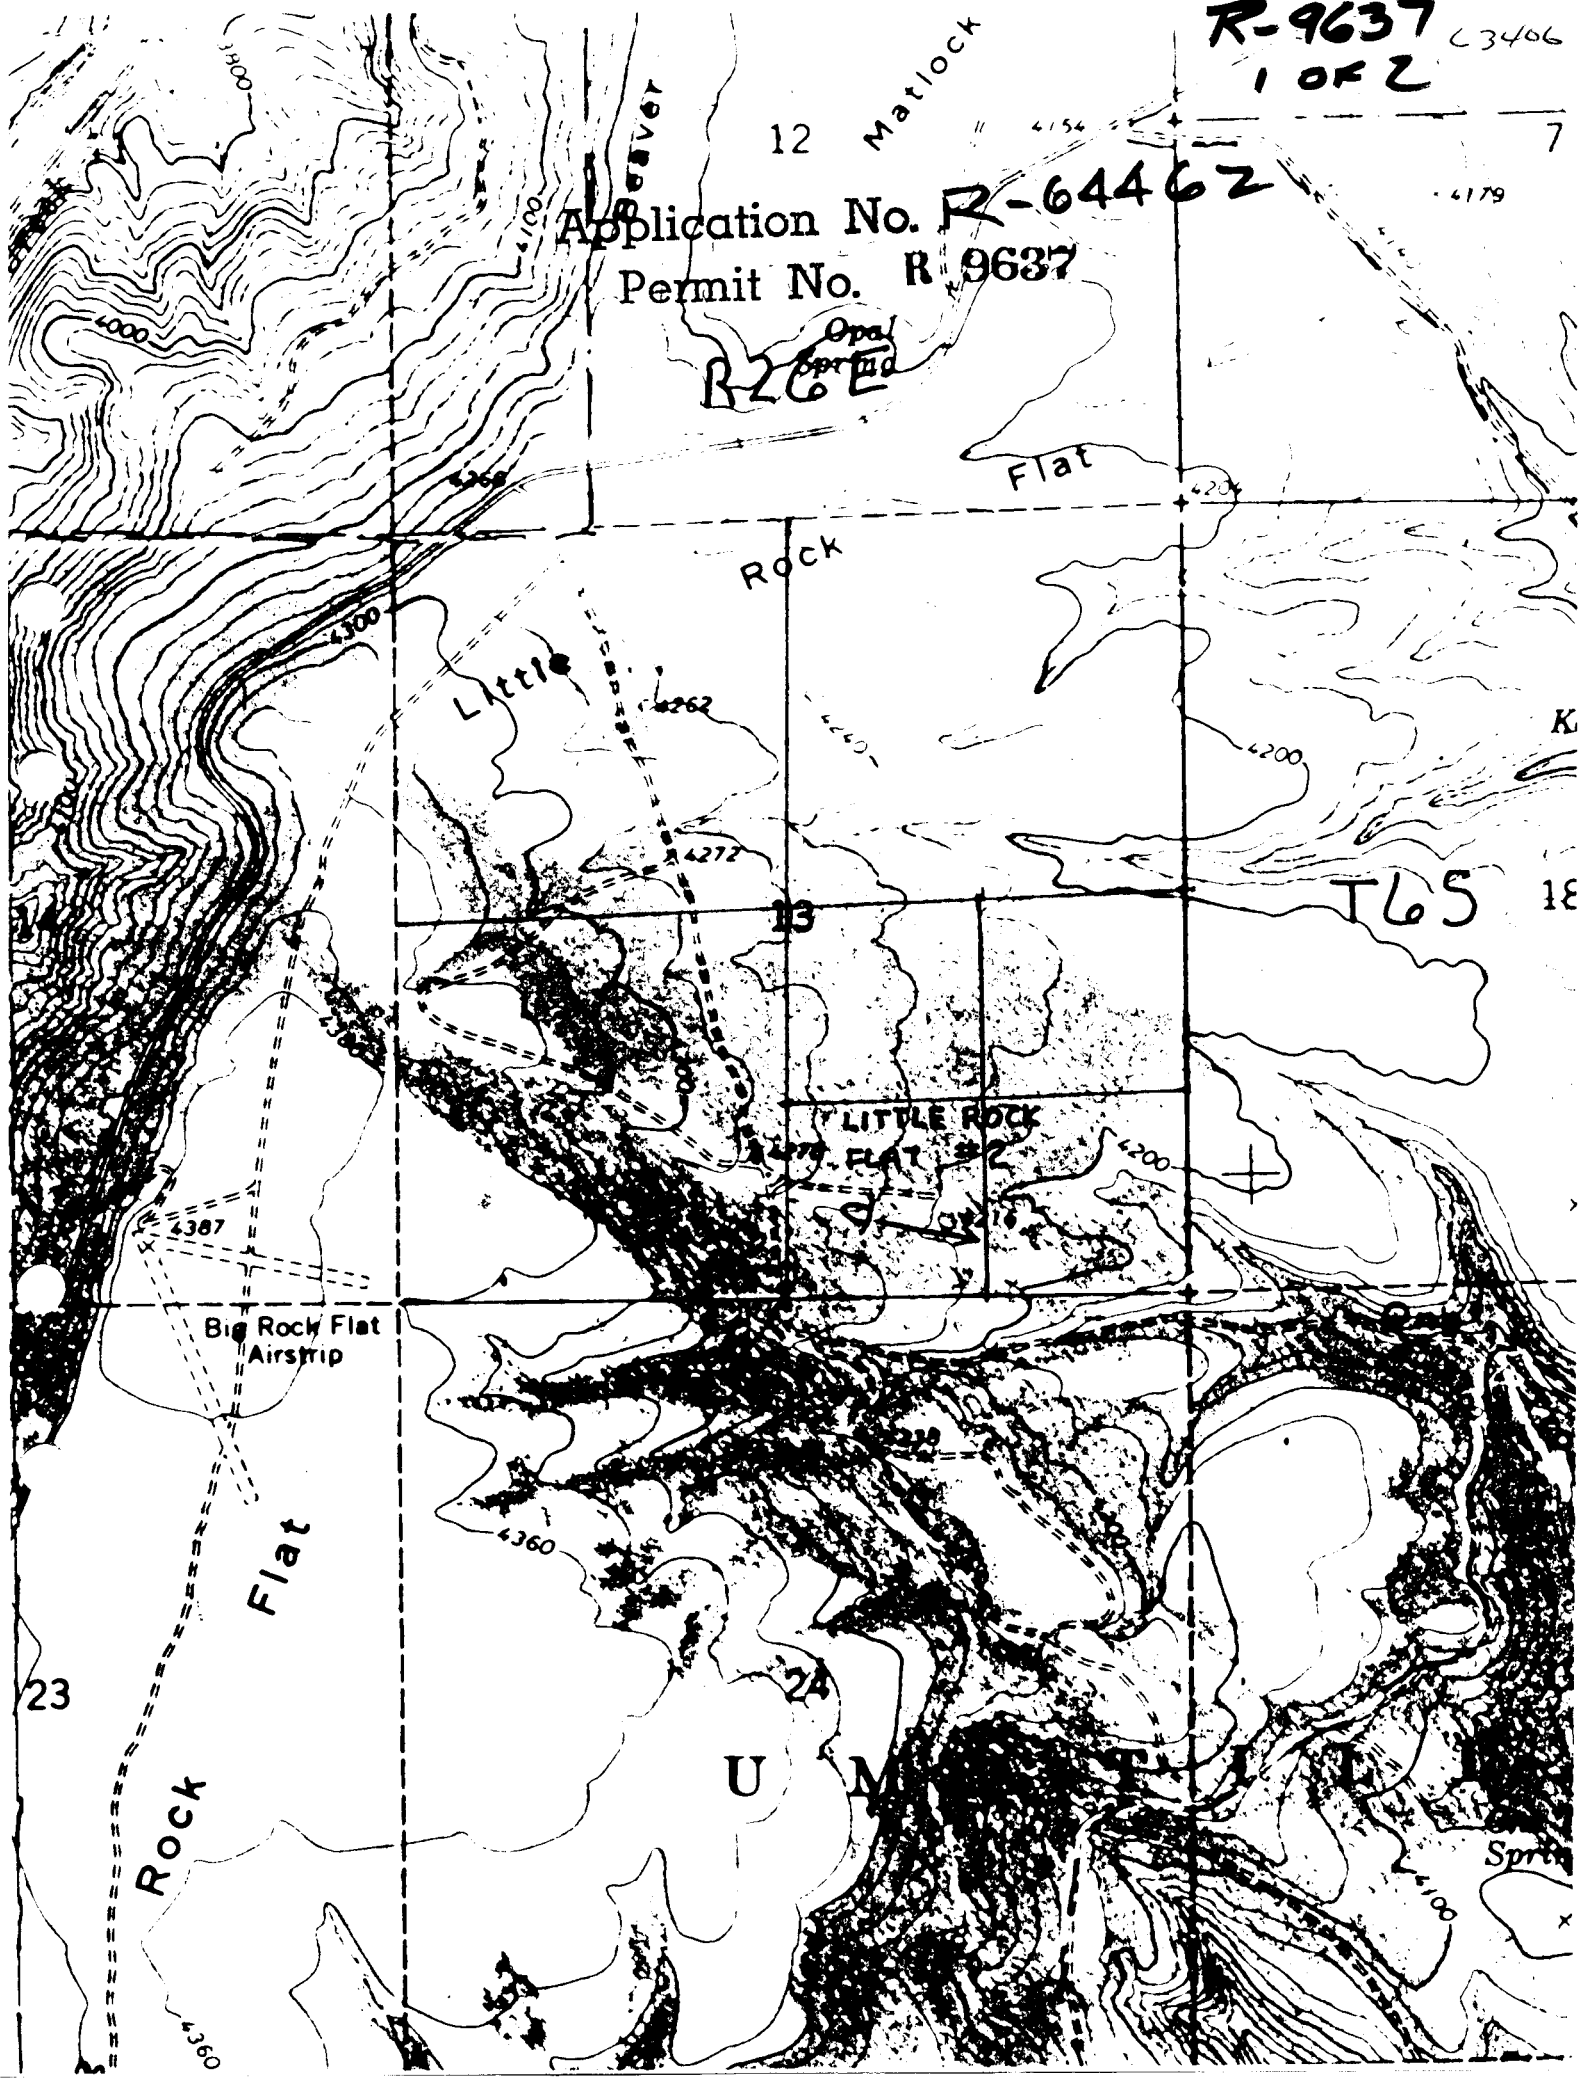

R-9637

2062

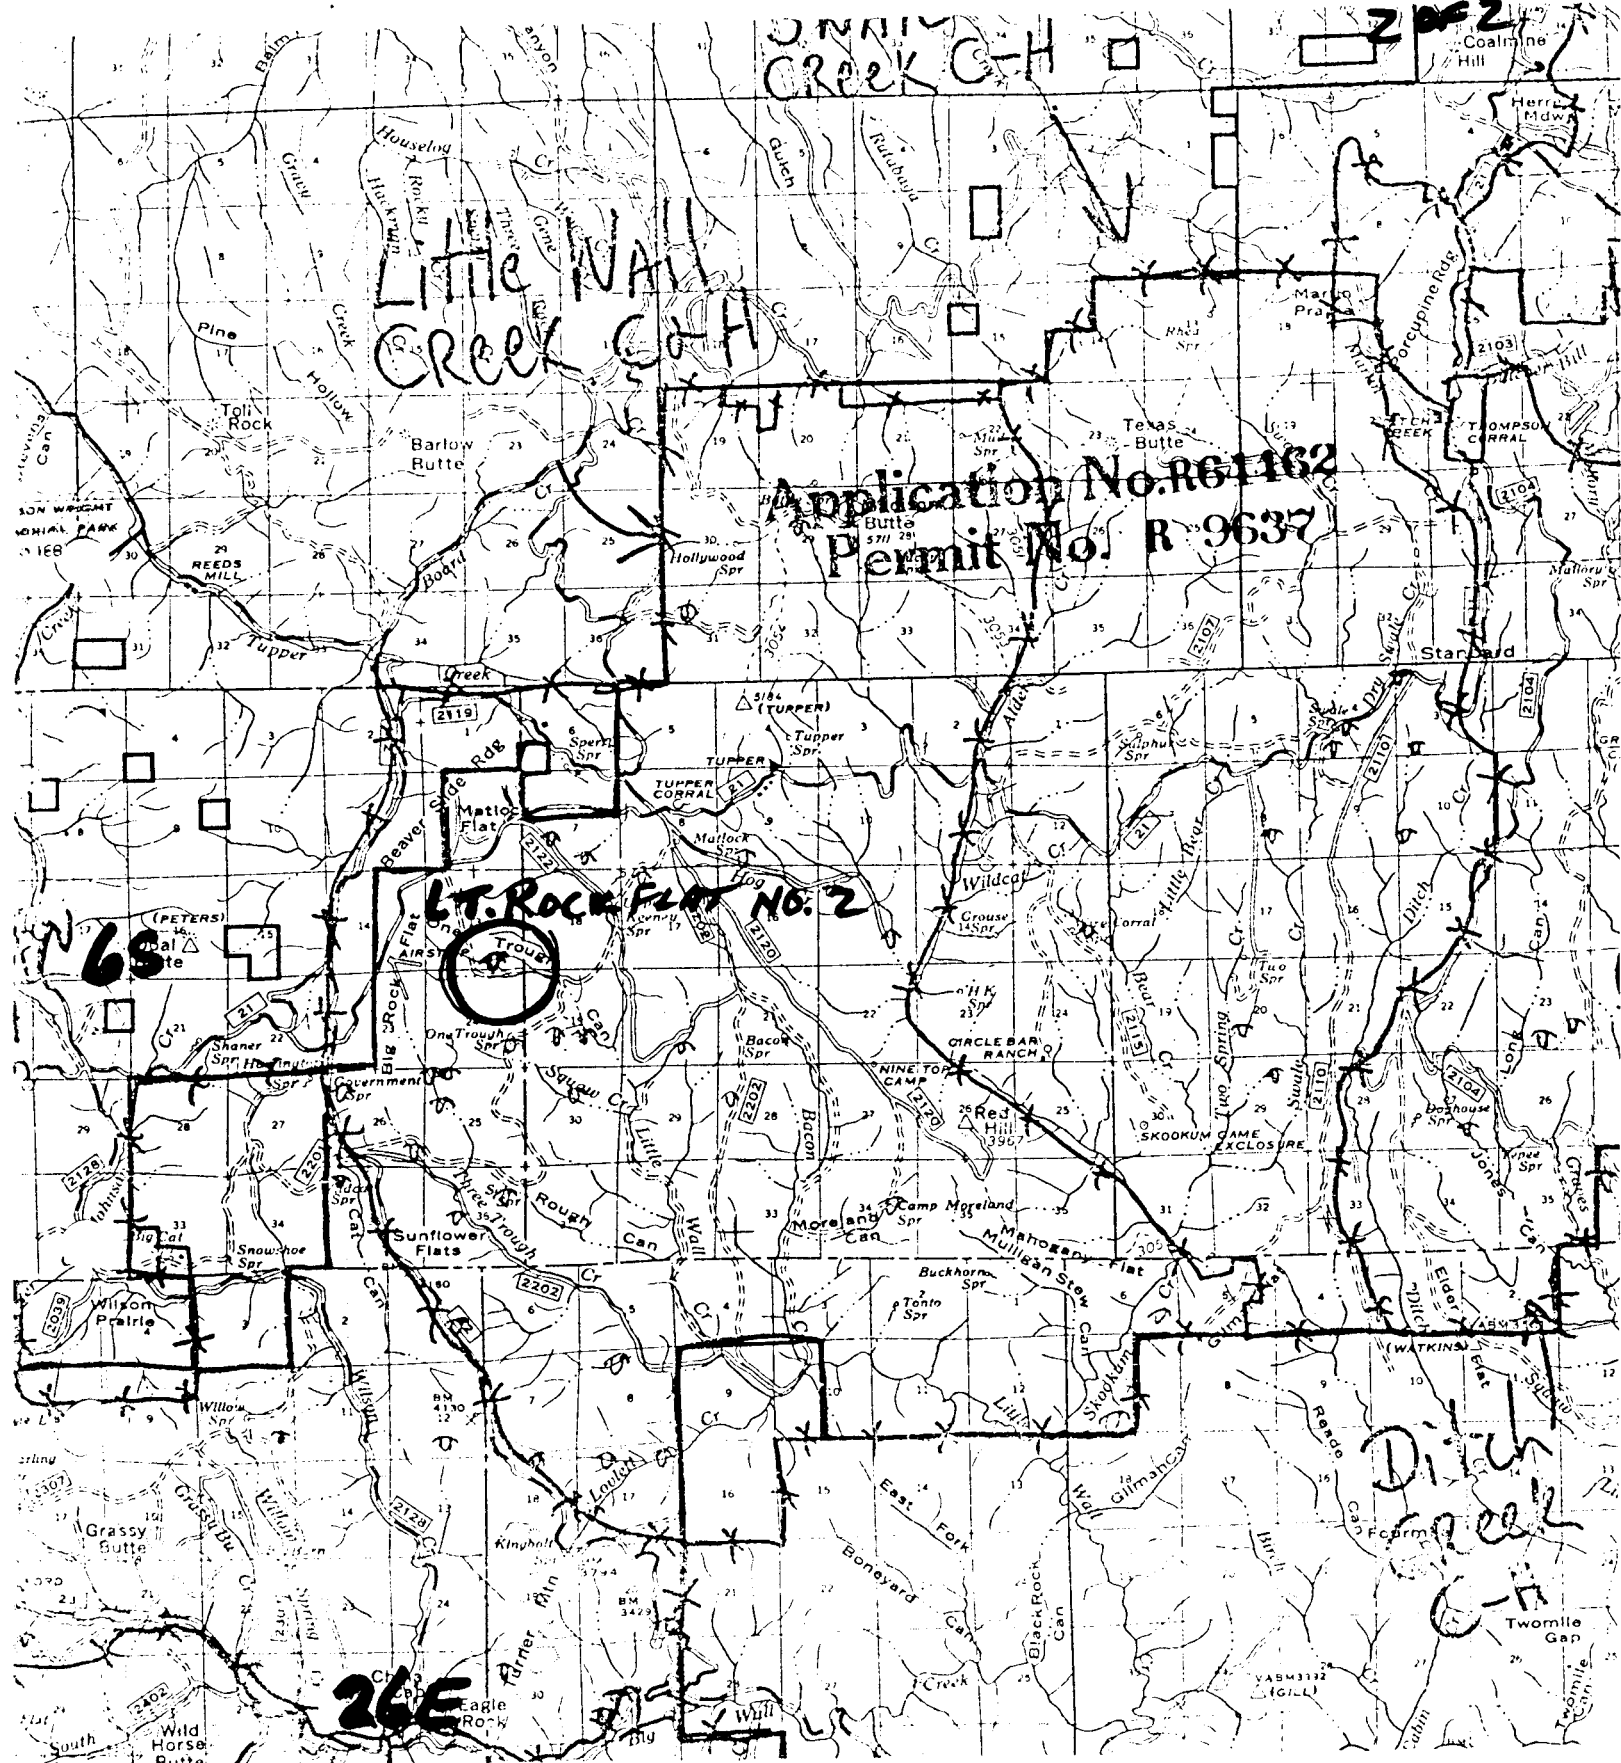

RECEIVED

OCT 11 1982

WATER RESOURCES DEPT.
SALEM, OREGON