


R-9638

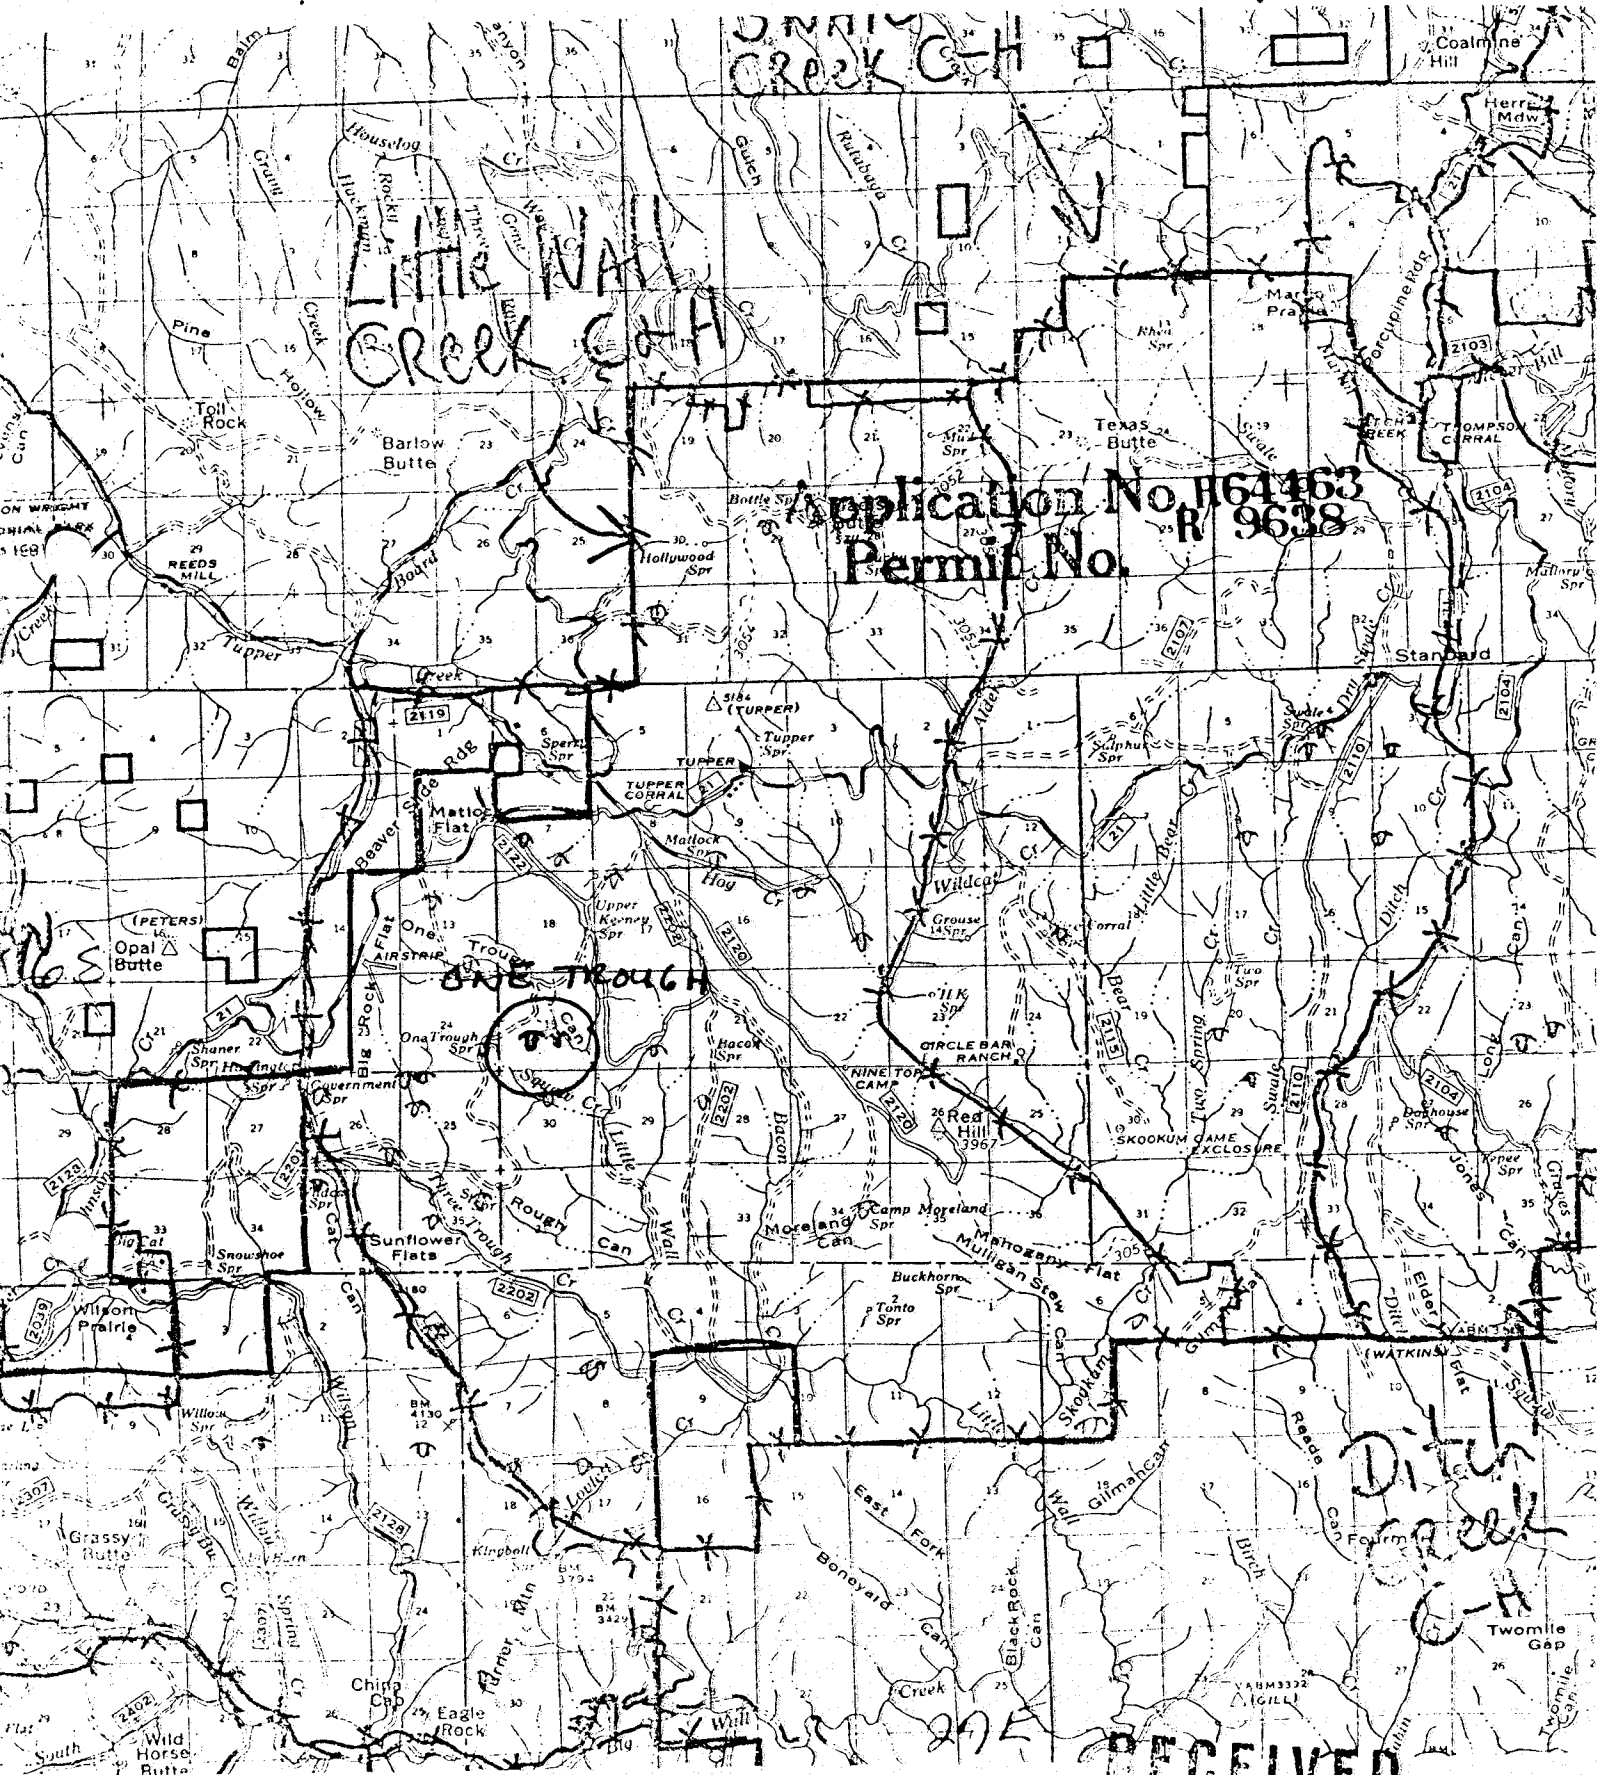

RECEIVED

OCT 11 1982

WATER RESOURCES DEPT.
SALEM, OREGON