

R-9639

1 OF 2

OWNERSHIP

65

RANGE

27E

SECTION

20

20

21

Application No. R64464
Permit No. R 9639

29

28

NAME


COUNTY

W. Lane


RECEIVED

OCT 11 1982

WATER RESOURCES DEPT.
SALEM, OREGON

R-9639

2042

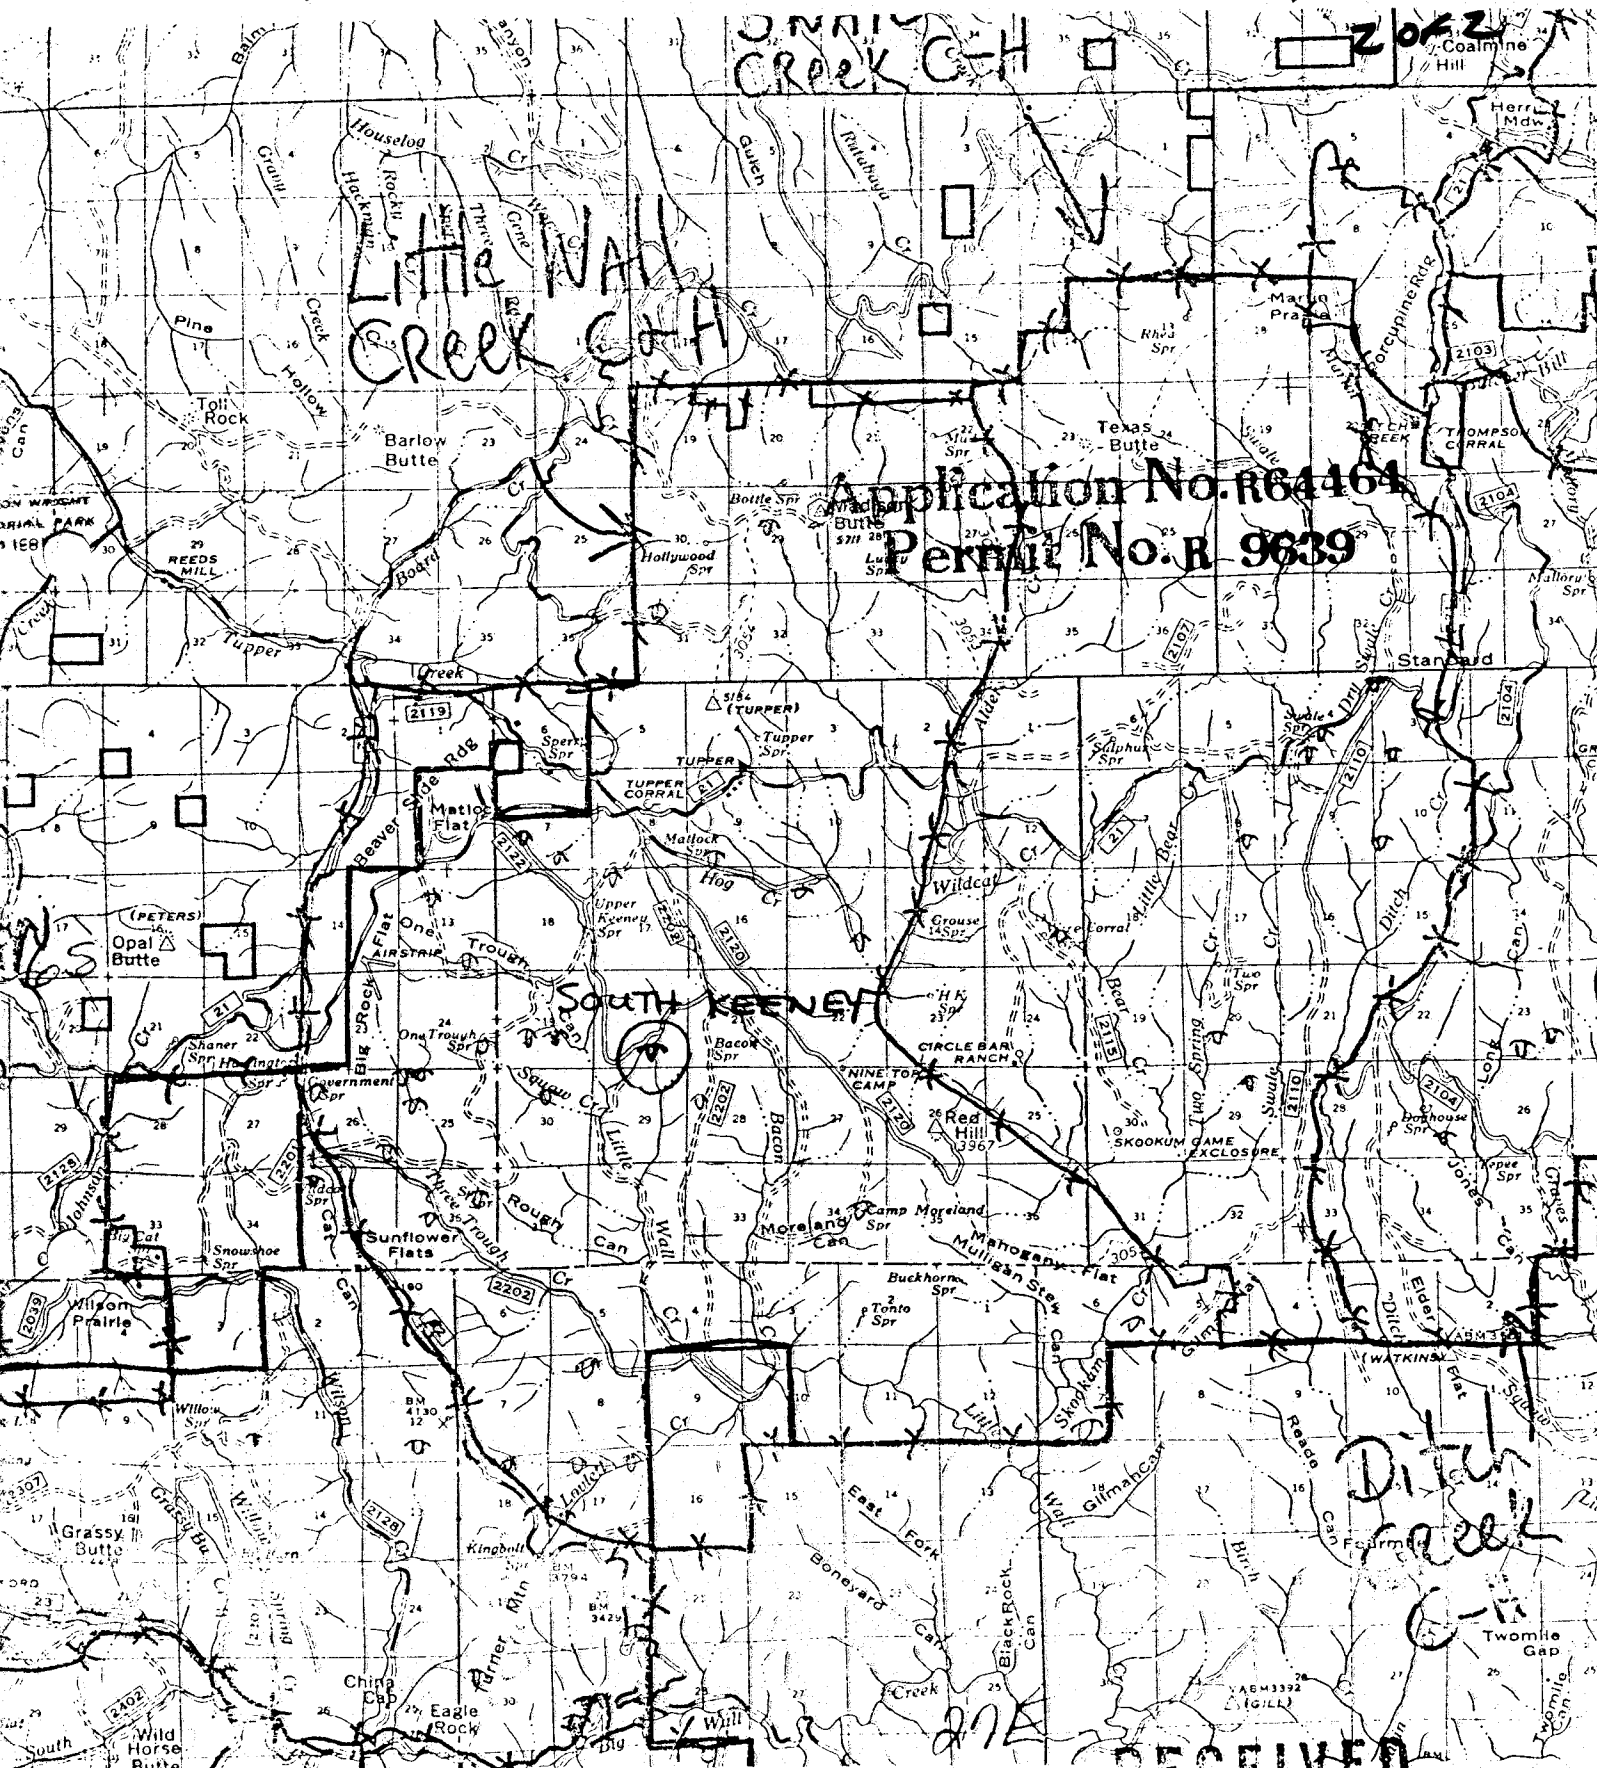

OCT 11 1982

WATER RESOURCES DEPT.
SALEM, OREGON