


R-9640

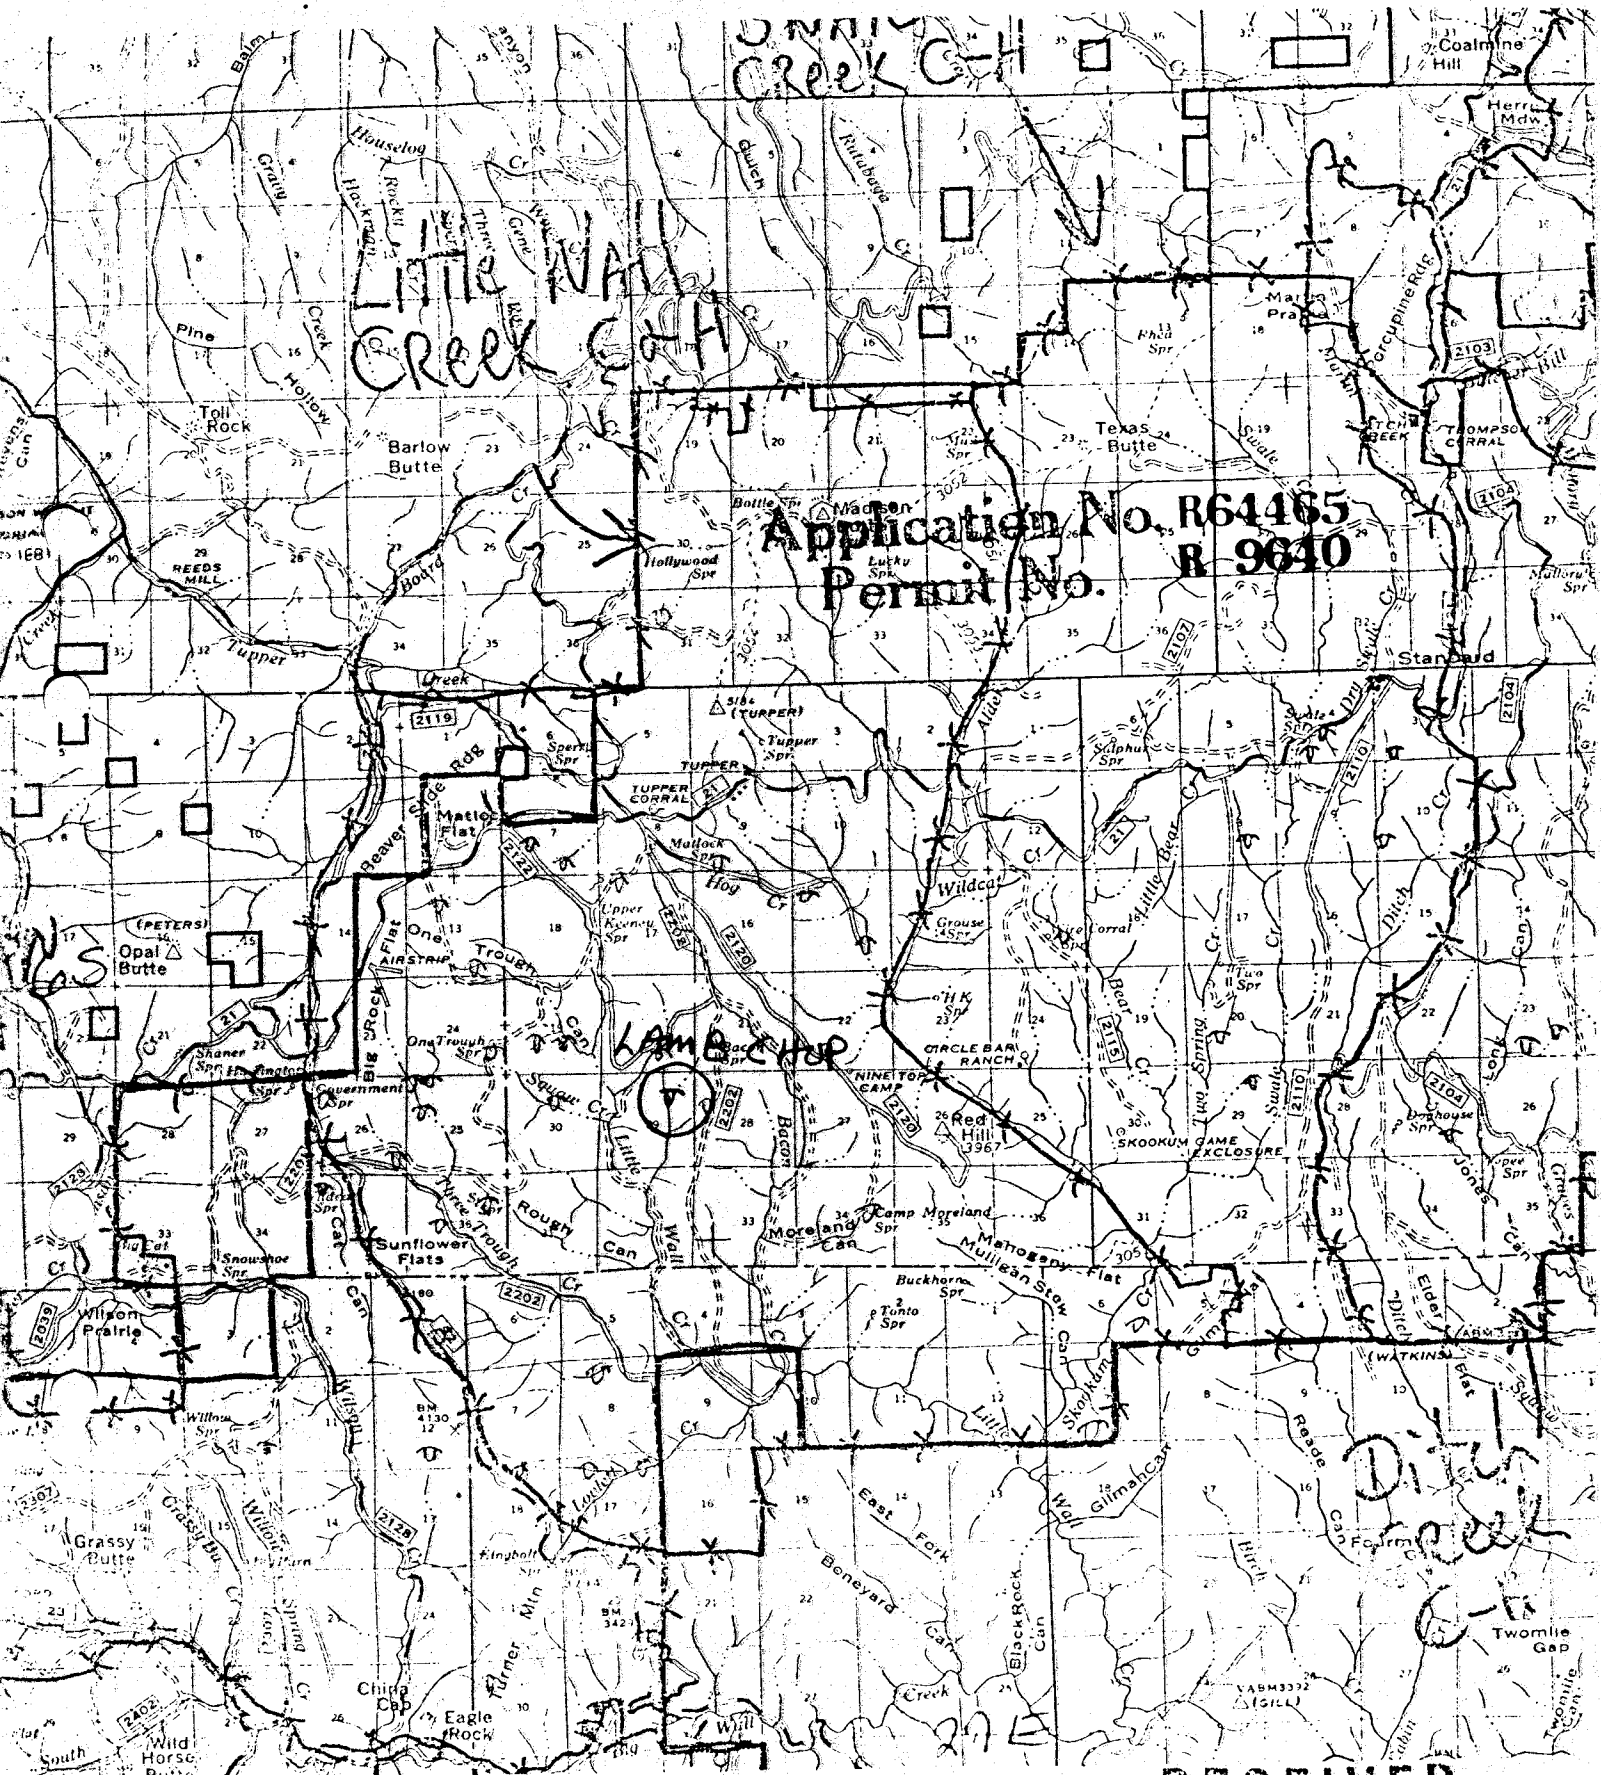

Application No. R64465
Permit No. R 9640

RECEIVED

OCT 11 1982

WATER RESOURCES DEPT.
SALEM, OREGON