

R-9645

1012

TOWNSHIP

16 S

RANGE

16 E

SECTION

22

24

19

Application No. R64470
Permit No. R 9645

25

30

NAME North Star Gold Rec COUNTY Malheur


RECEIVED

OCT 11 1982

WATER RESOURCES DEPT.
SALEM, OREGON

R-9645

Z OK 2

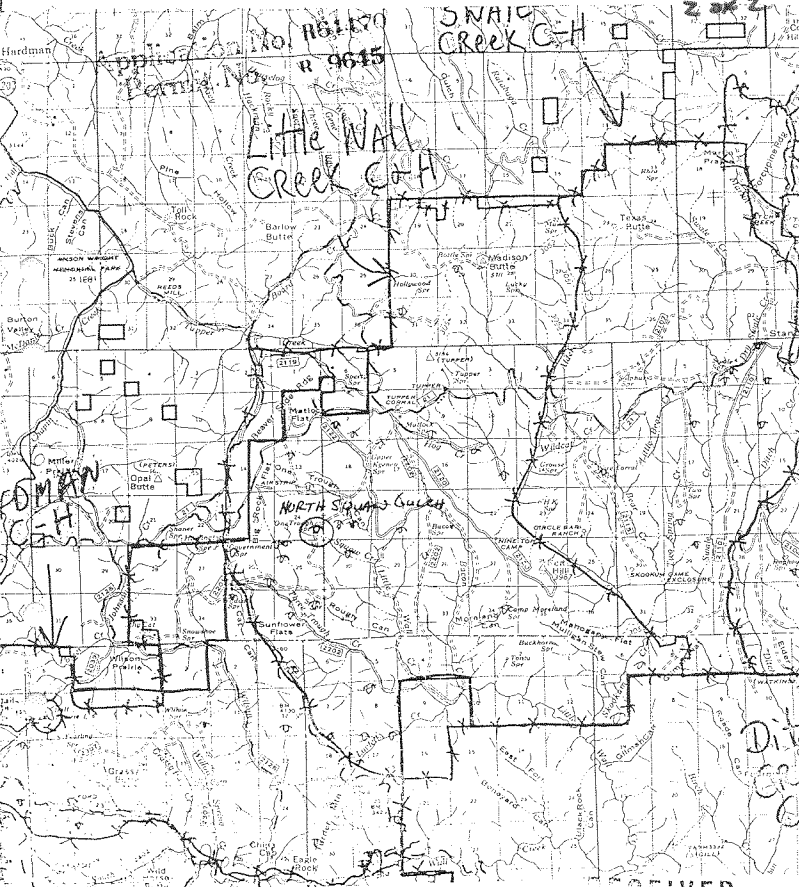

RECEIVED

OCT 11 1982

WATER RESOURCES DEPT.
SALEM, OREGON