

C3016 R-9647


Application No. B64472
Permit No. R 9647

T. 5S.
07'
30"

T. 6S.

T. 7S.


T. 8S.

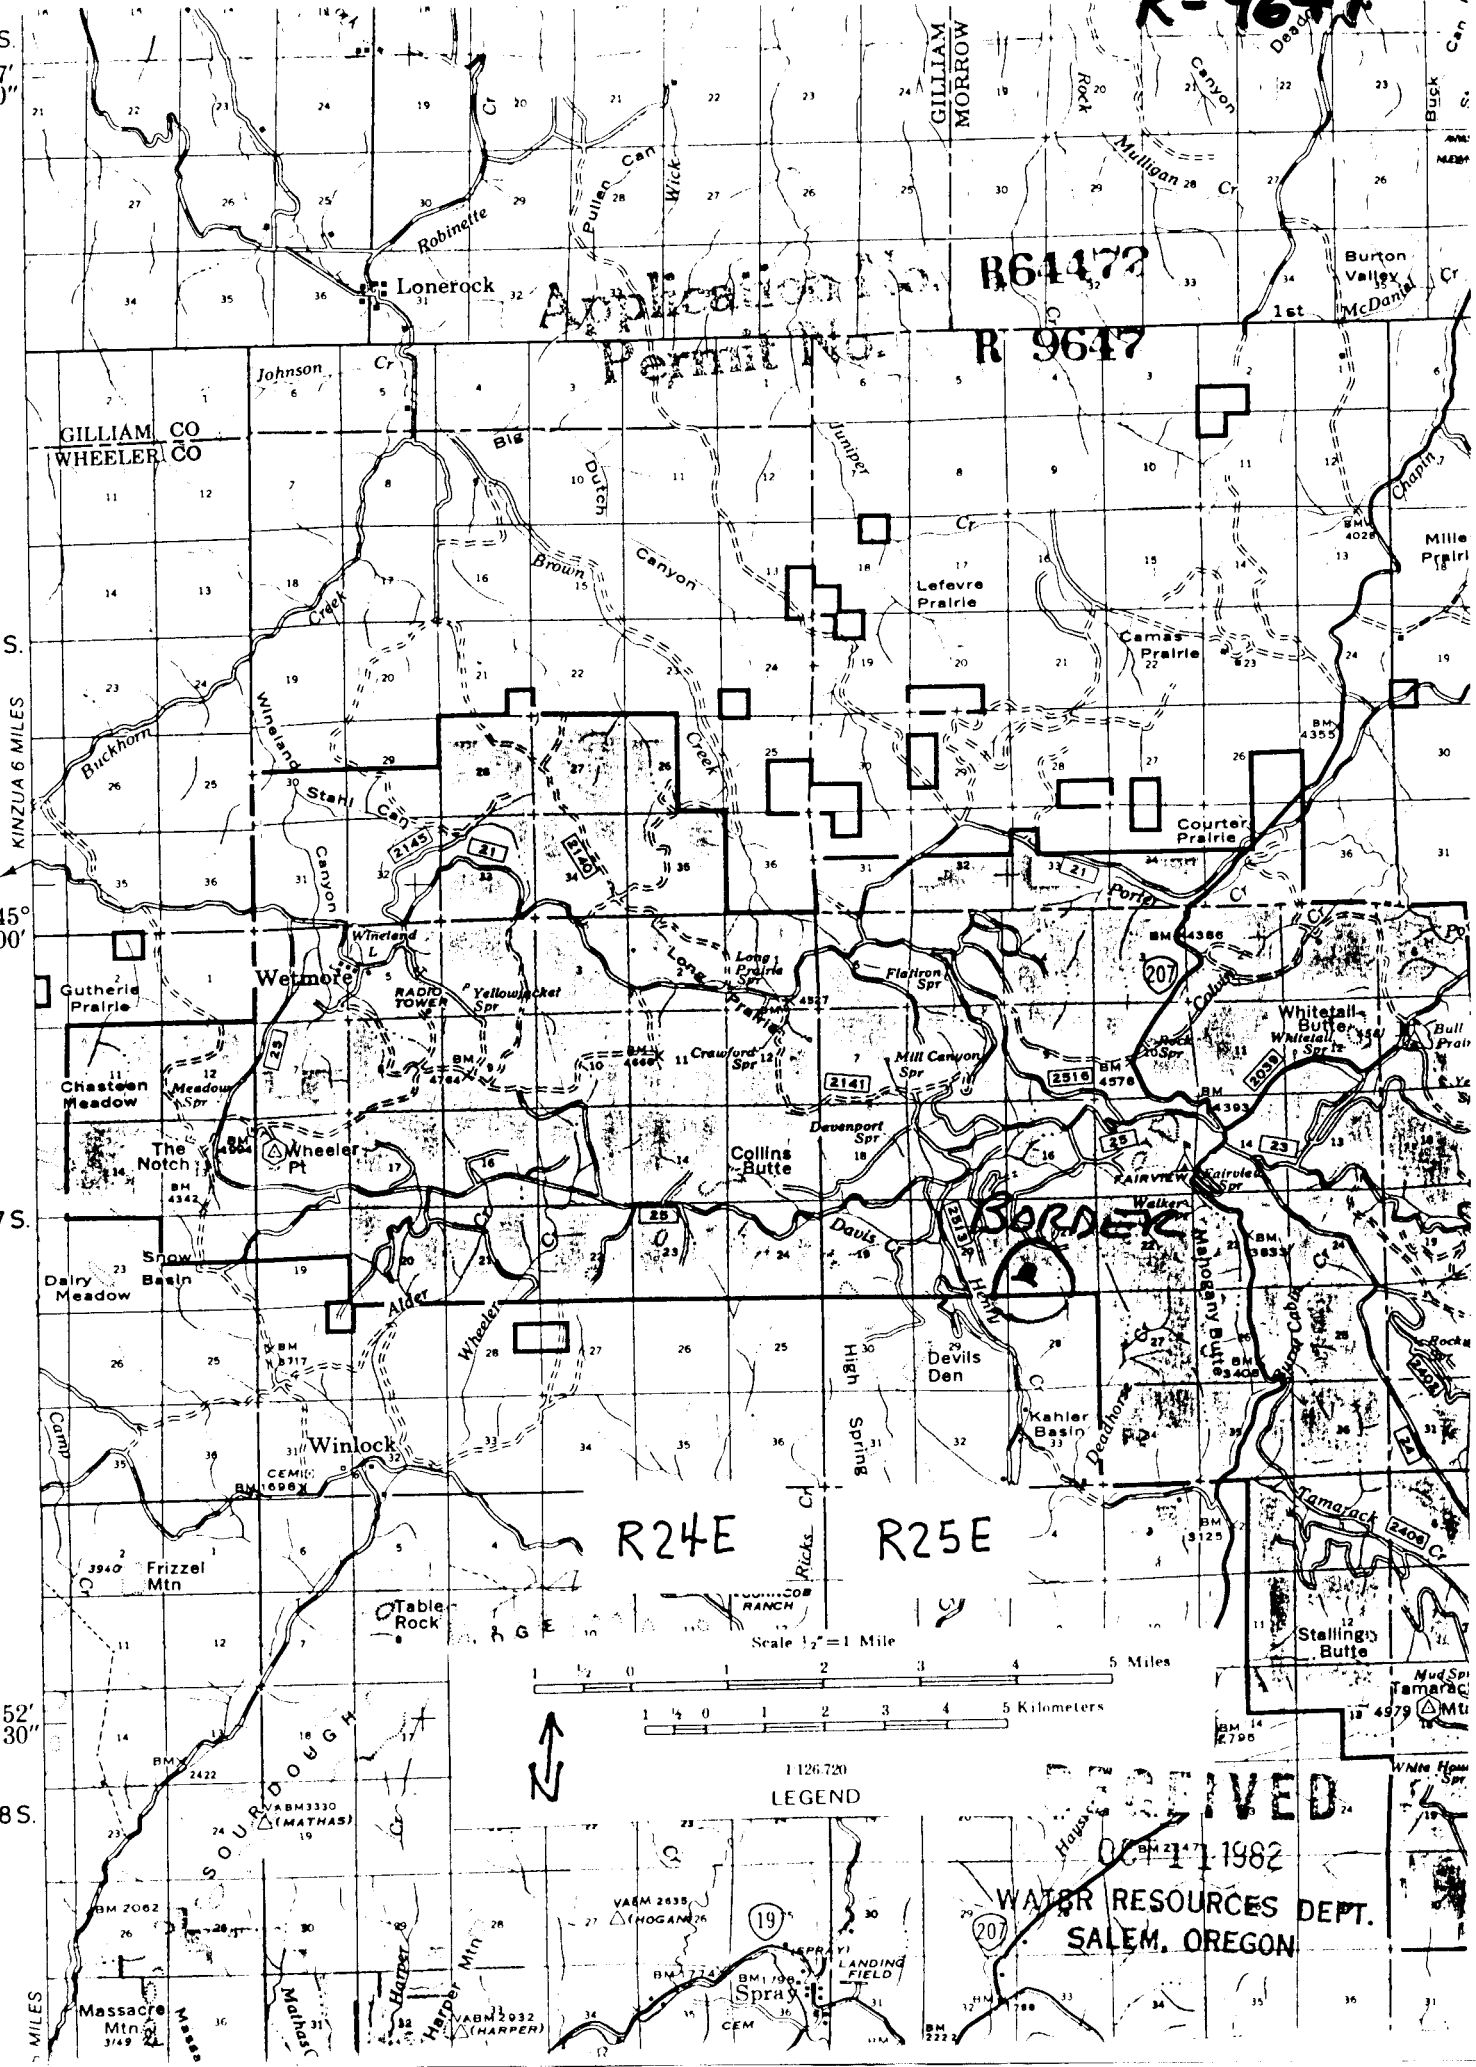

R24E

R25E

Scale 1" = 1 Mile

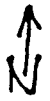

1126720
LEGEND

RECEIVED

1982

WATER RESOURCES DEPT.
SALEM, OREGON