


6347 R-9648

T. 5 S.
07' 30"

T. 6 S.

T. 7 S.

T. 8 S.

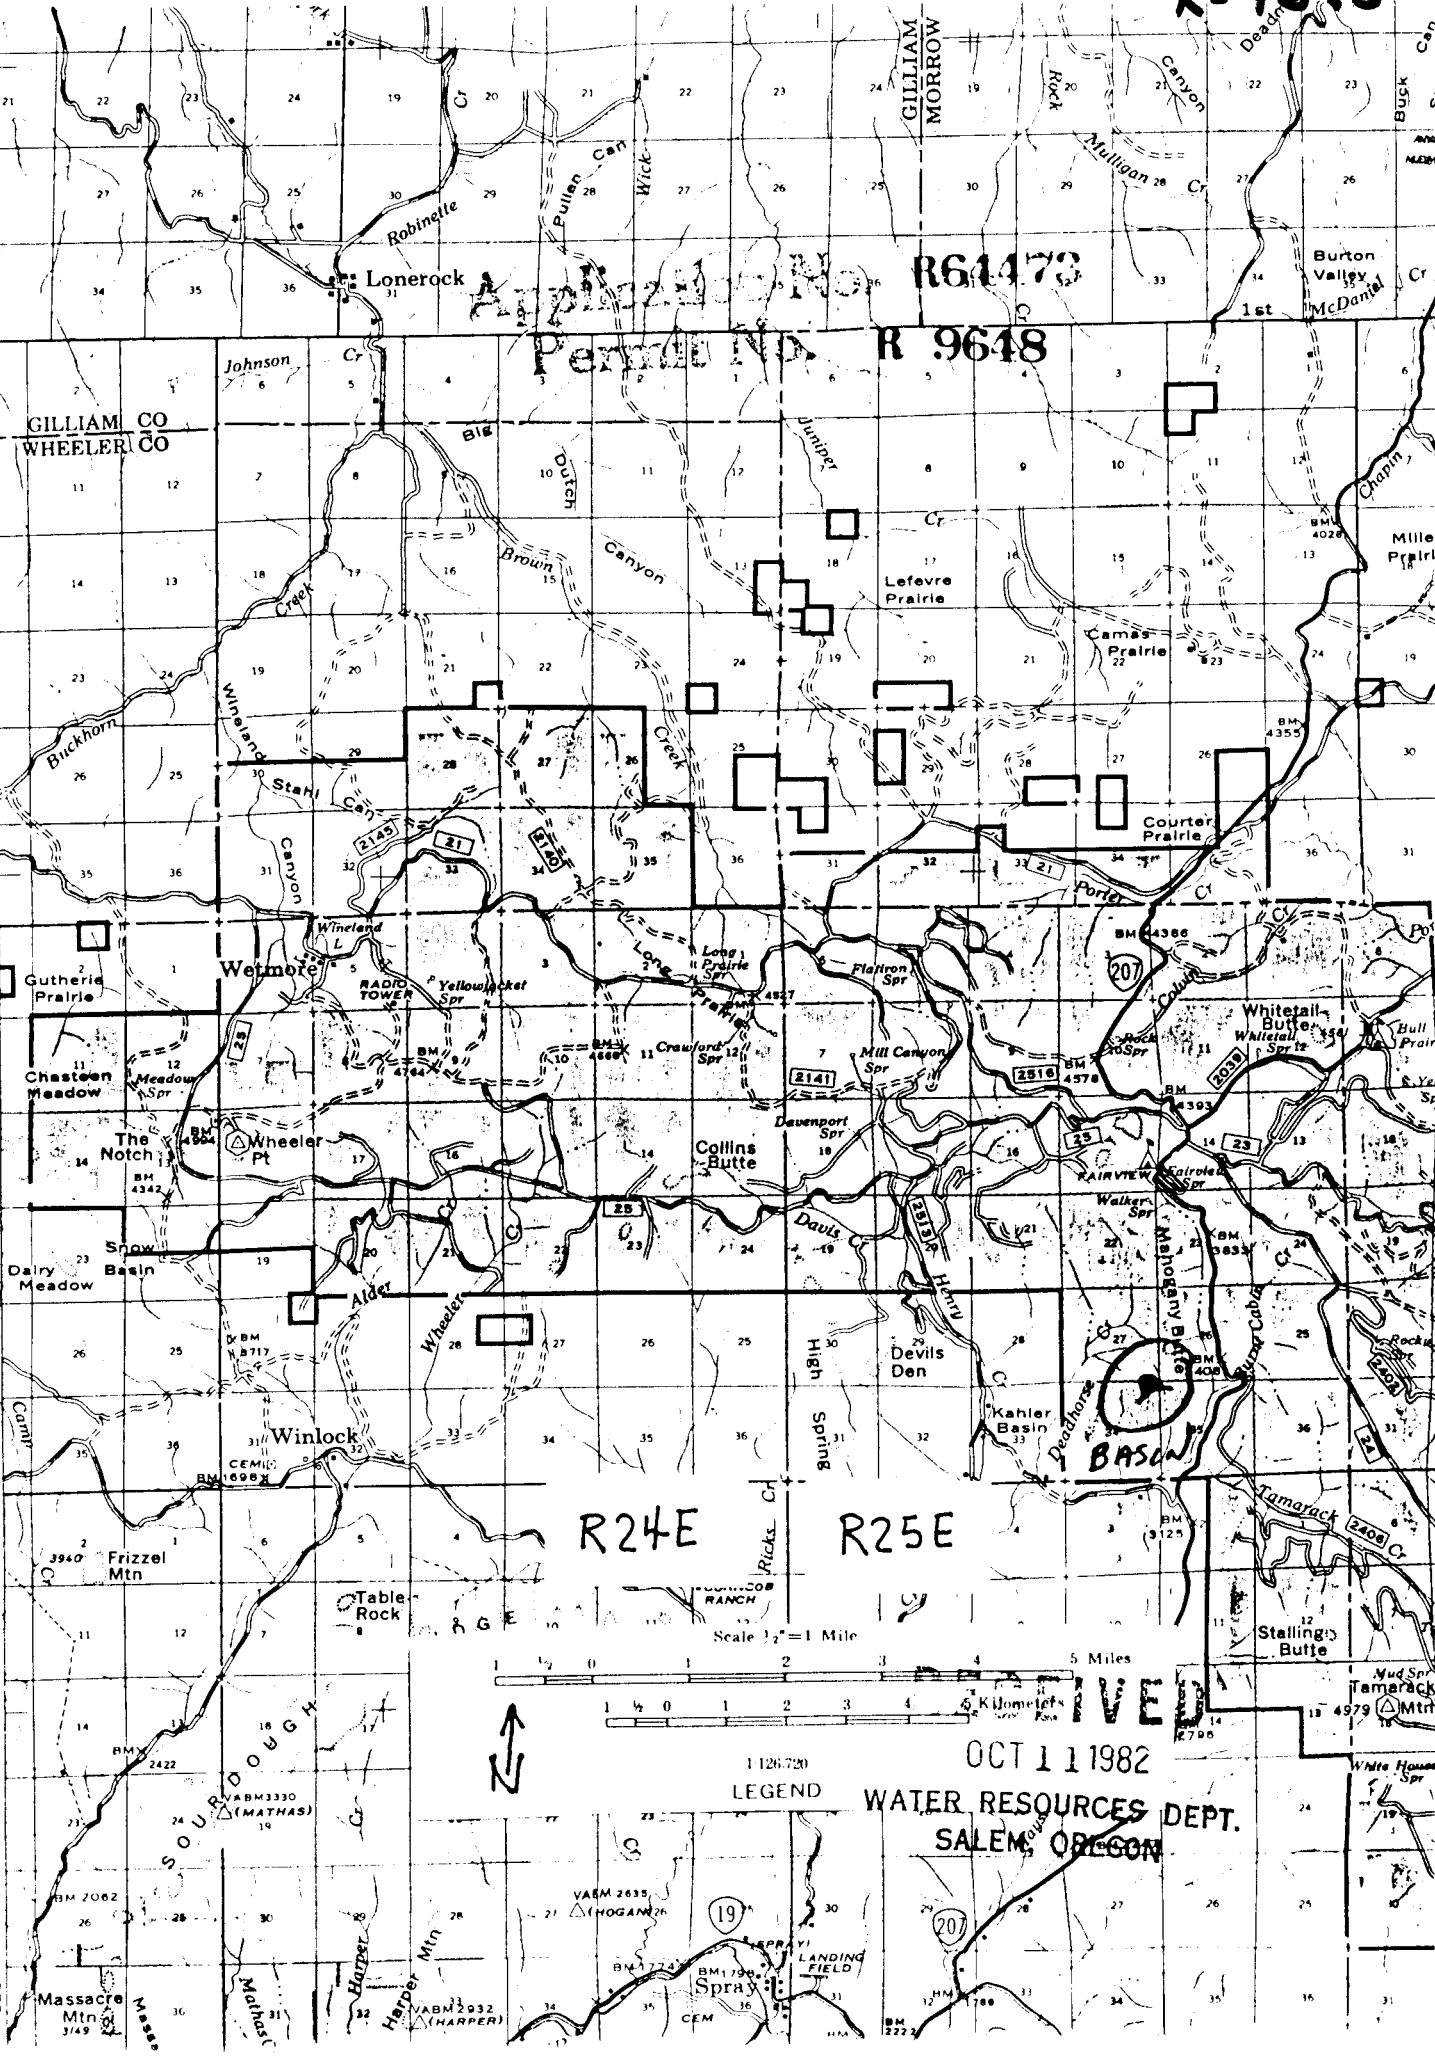

Permit No. R 9648

R24E R25E

Scale 1" = 1 Mile

1 1/4 0 1 2 3 4 5 Miles

1 1/4 0 1 2 3 4 5 Kilometers

LEGEND

OCT 11 1982
WATER RESOURCES DEPT.
SALEM, OREGON

