


23478 R-9649
10K 2

Application No. R64474
Permit No. R 9649

GILLIAM CO
WHEELER CO

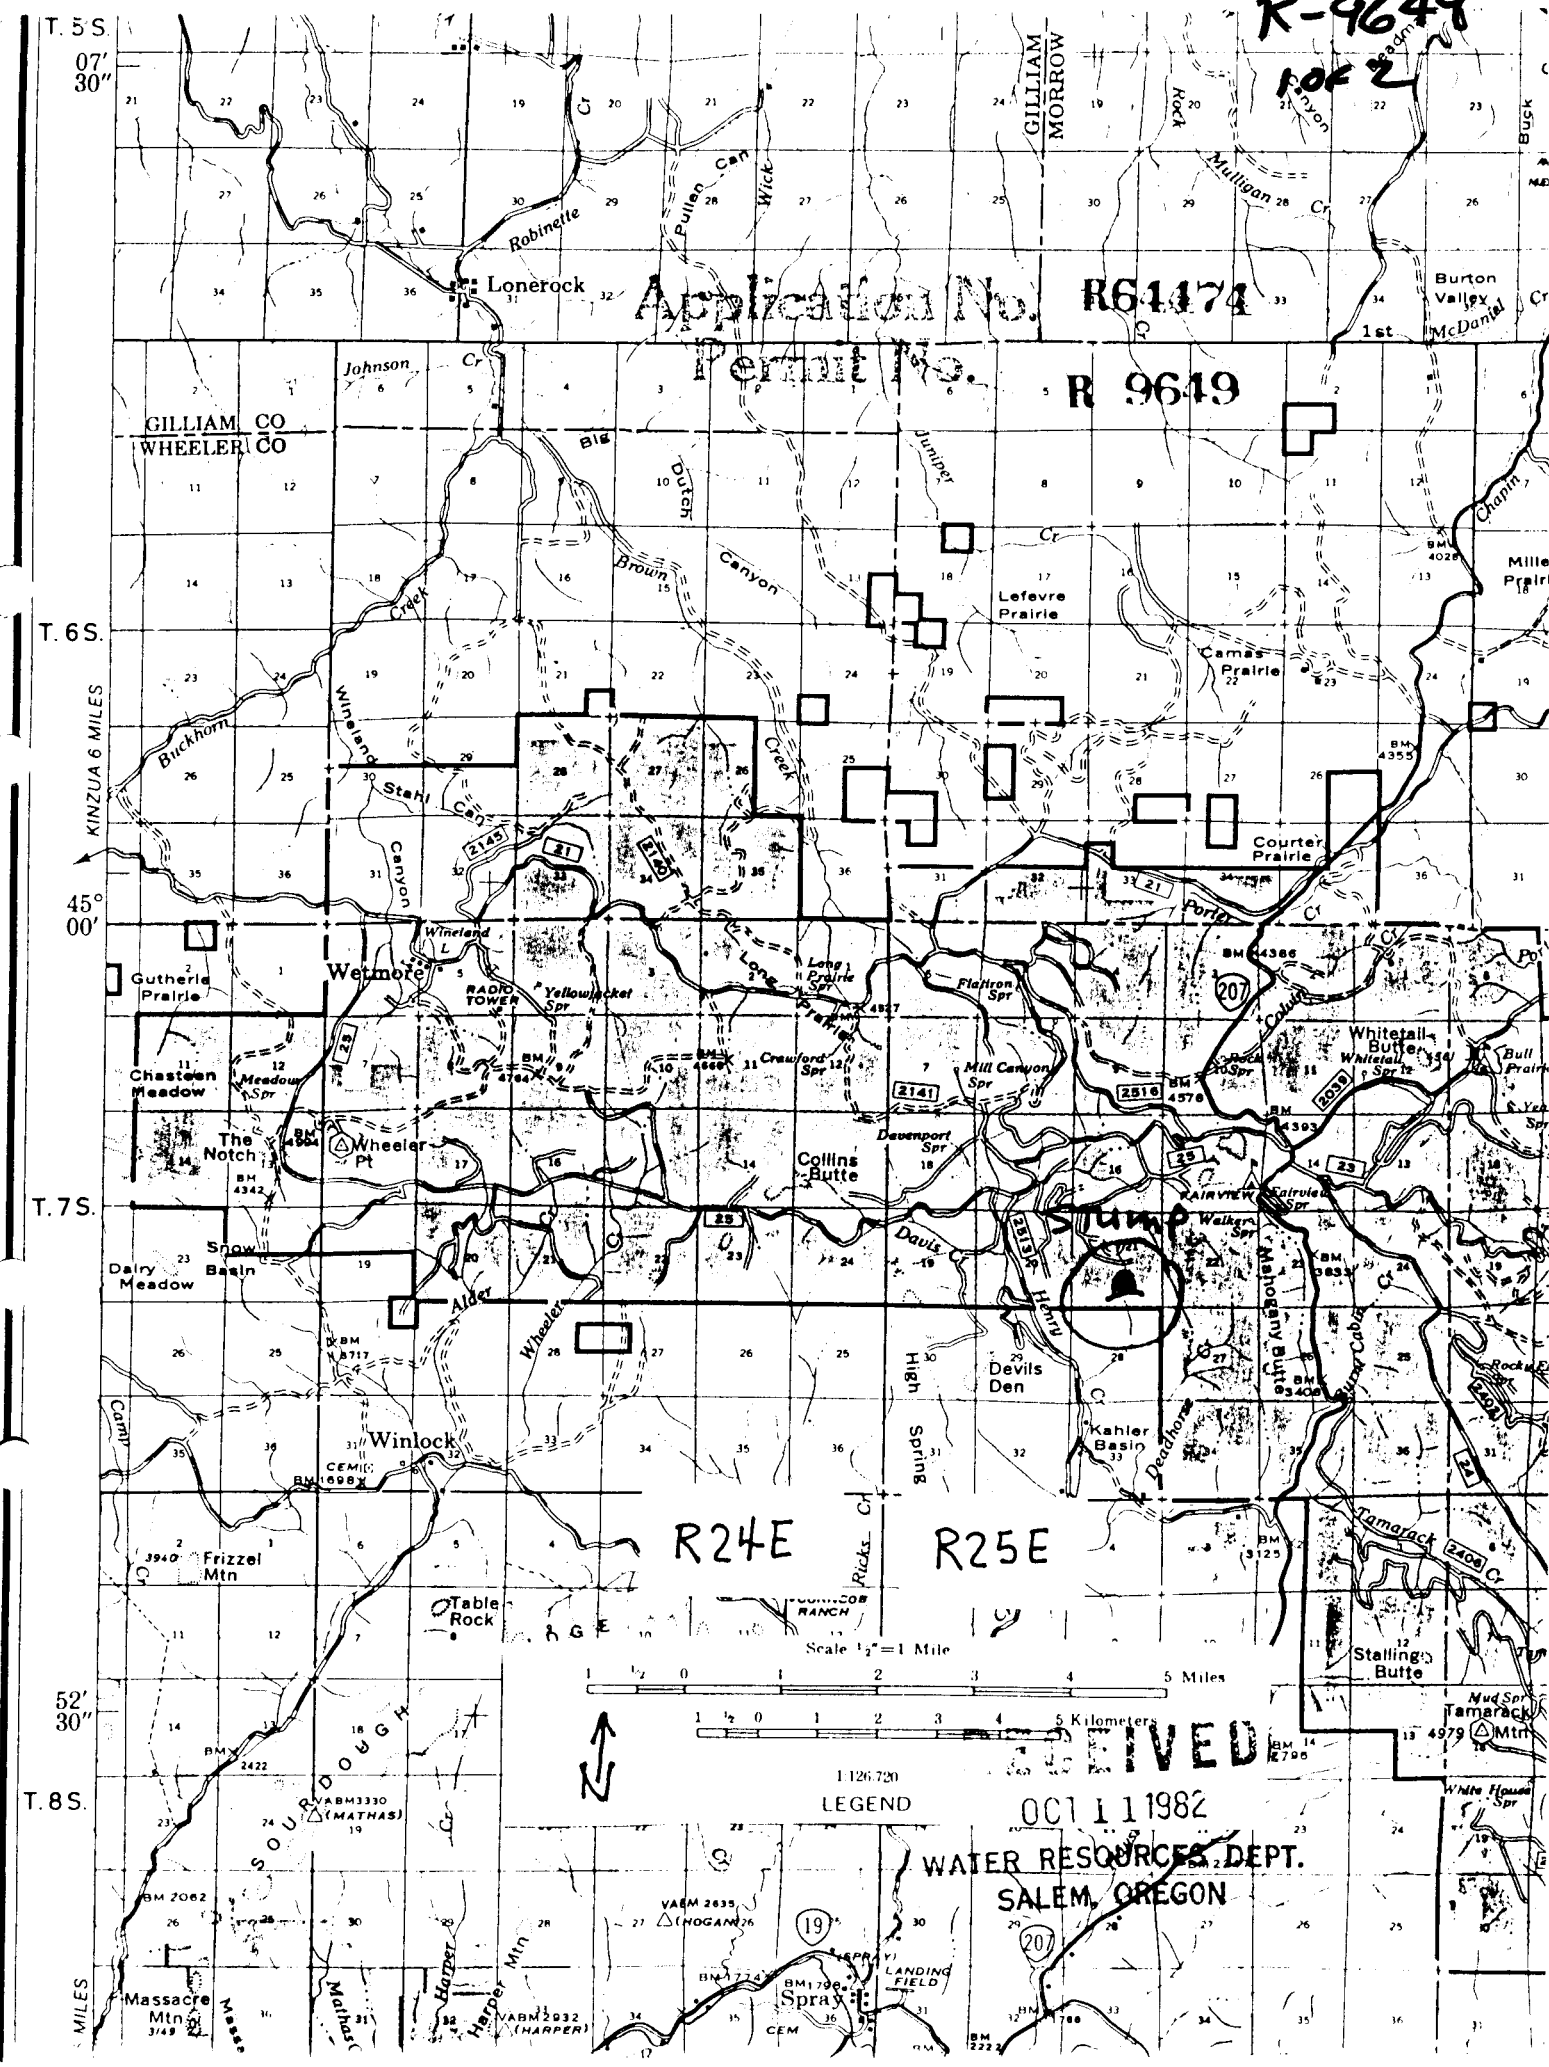

R24E

R25E

Scale 1/2" = 1 Mile
1 1/2 0 1 2 3 4 5 Miles
1 1/2 0 1 2 3 4 5 Kilometers

LEGEND

OC 11 1982
WATER RESOURCES DEPT.
SALEM, OREGON

