

STATE OF OREGON WATER RESOURCES DEPARTMENT
 APPLICATION FOR A PERMIT TO CONSTRUCT A RESERVOIR

RECEIVED


APPLICANT: USDA FOREST SERVICE, MT. HOOD NATIONAL FOREST

SEP 18 1983


Township 4S Range 11E Section 15

WATER RESOURCES DEPT.
 SALEM, OREGON


Reservoir (Pond) Name Mallard Pond

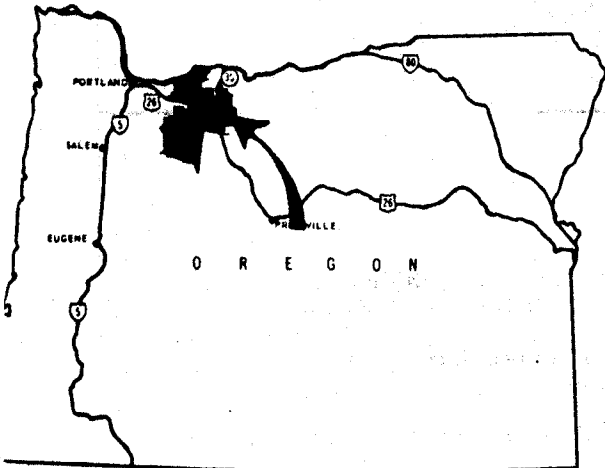

Vicinity Map

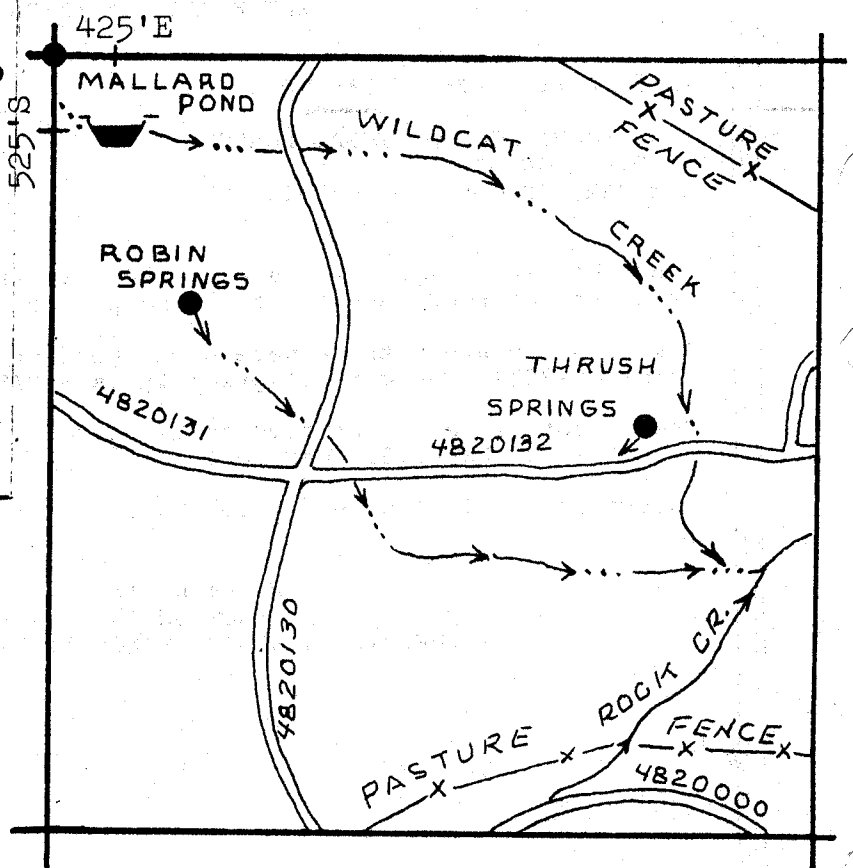

SCALE

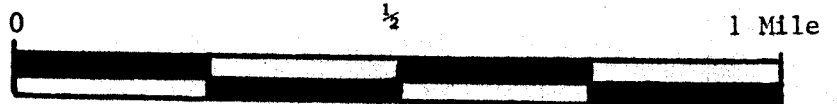


4" to 1 mile

RECEIVED

DEC 1 1983
 WATER RESOURCES DEPT.
 SALEM, OREGON

TYPICAL DEVELOPMENT

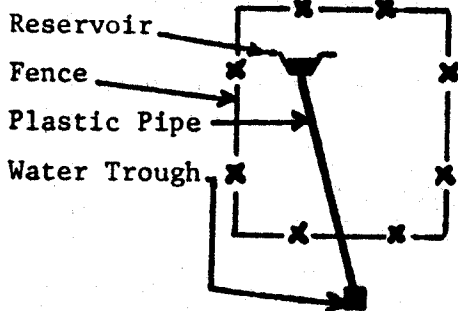

LEGEND

- Int. Stream
- Creek
- Flow Direction
- Reservoir
- Road
- Exclosure Fence

Application No. R-6603
 Permit No. R 9874