


Application No. R-63285
Permit No. 9929

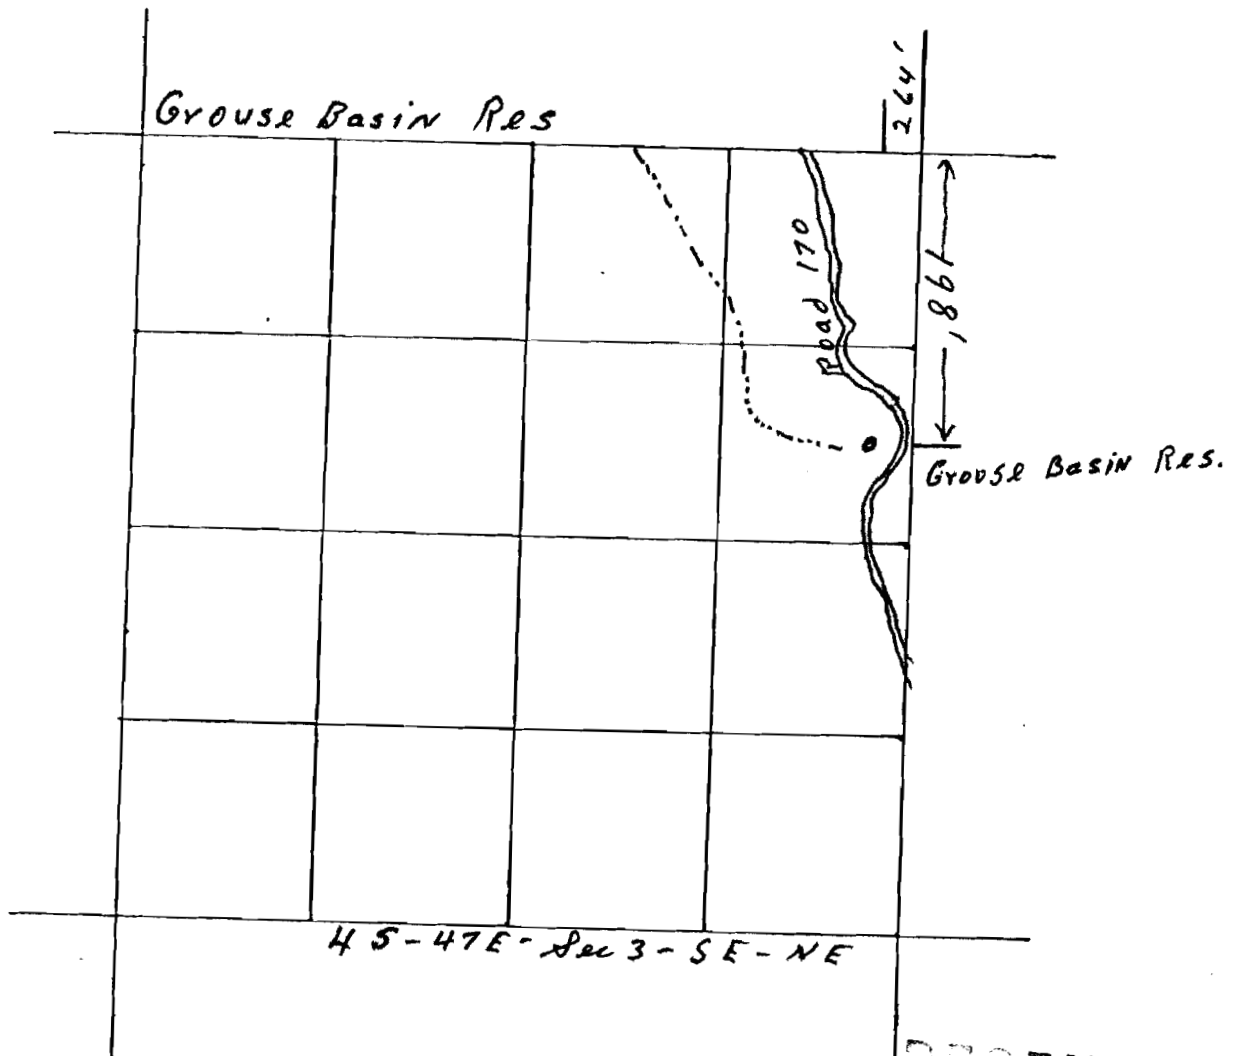

RECEIVED

AUG 19 1982

WATER RESOURCES
SALEM, OREGON

4 inches = 1 mile