


Application No. R63888

Permit No. R 9930

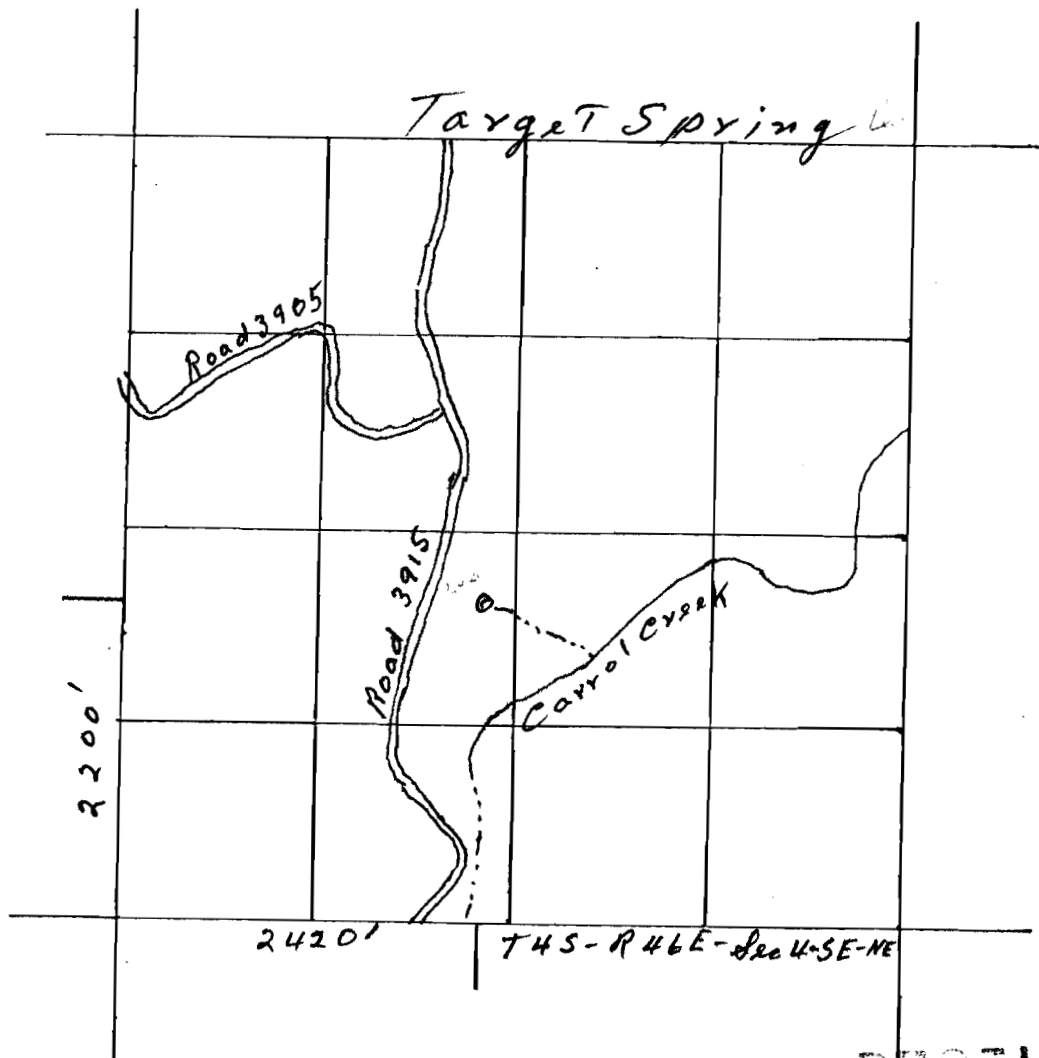

RECEIVED

AUG 19 1982

WATER RESOURCES
SALEM, OREGON

4 inches = 1 mile