
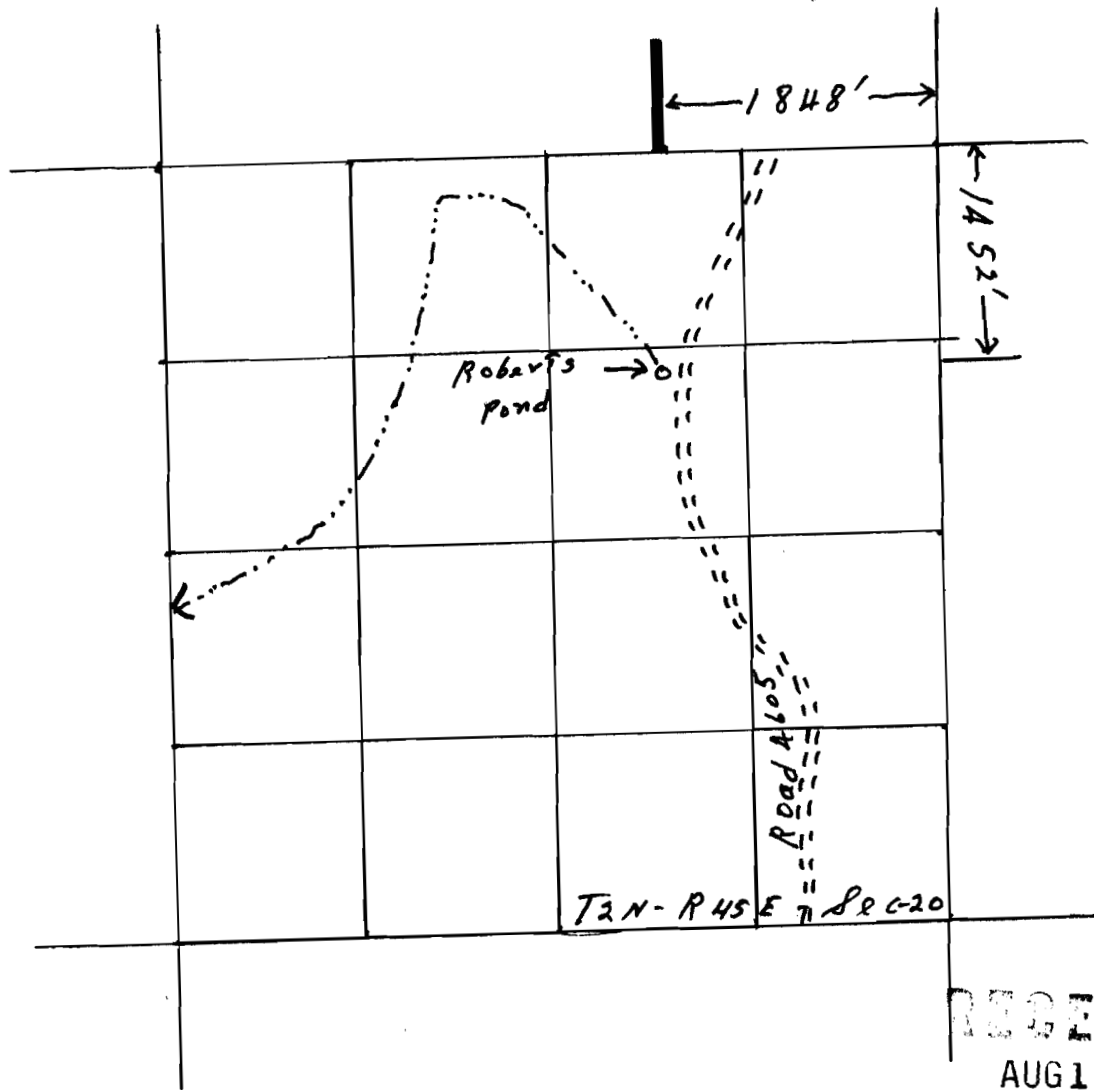


Application No. R63889
Permit No. R 9931

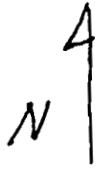

RECEIVED

AUG 19 1982

WATER RESOURCES
SALEM, OREGON

4 inches = 1 mile