


Application No. R-63891
Permit No. R 9933

N

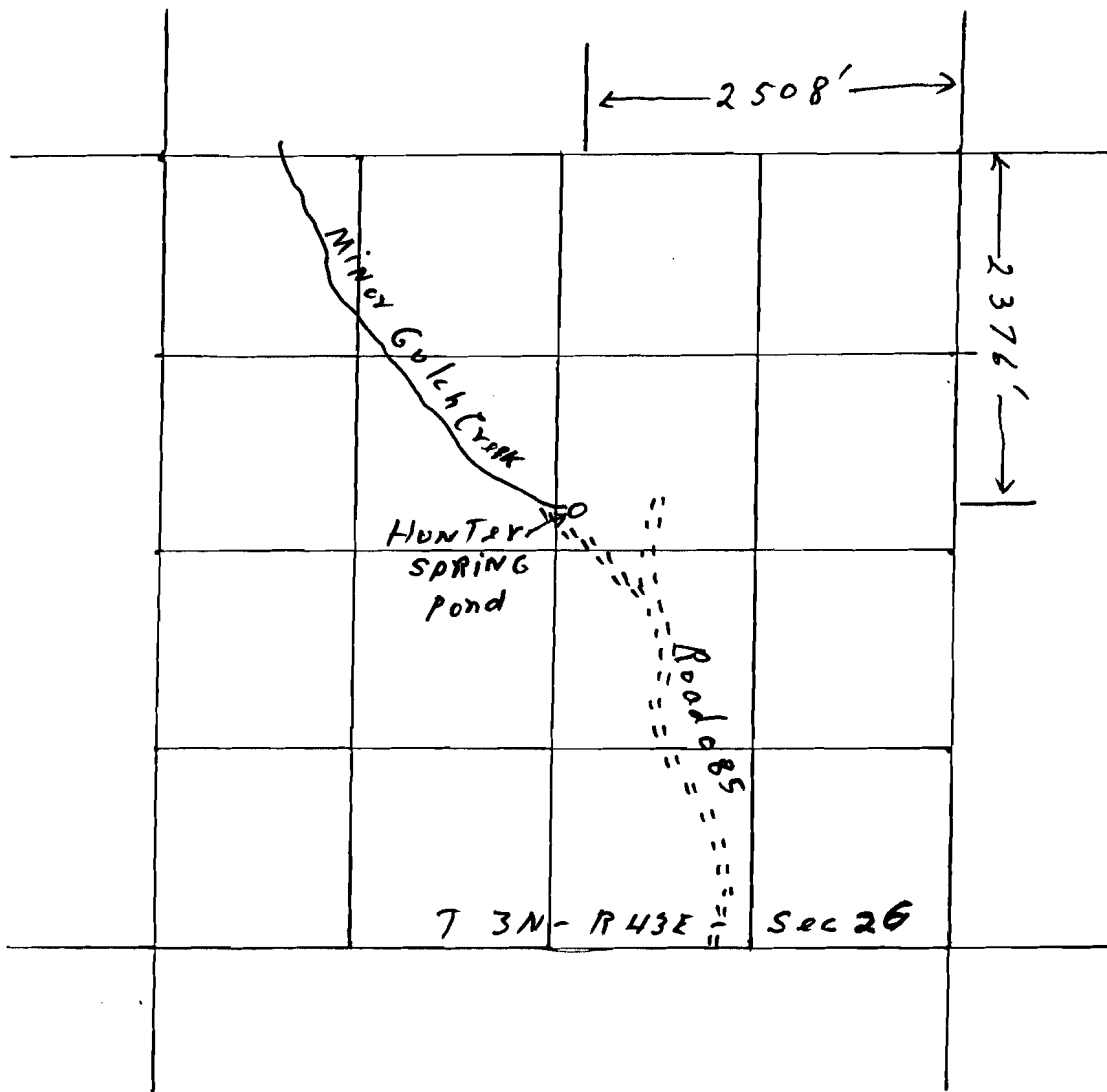

RECEIVED

AUG 19 1982

WATER RESOURCES DEPT.
SALEM, OREGON

4 inches = 1 mile