


ON FILE
Application No.
Permit No.

Application No. R 63892
Permit No. R 9934

N ↑

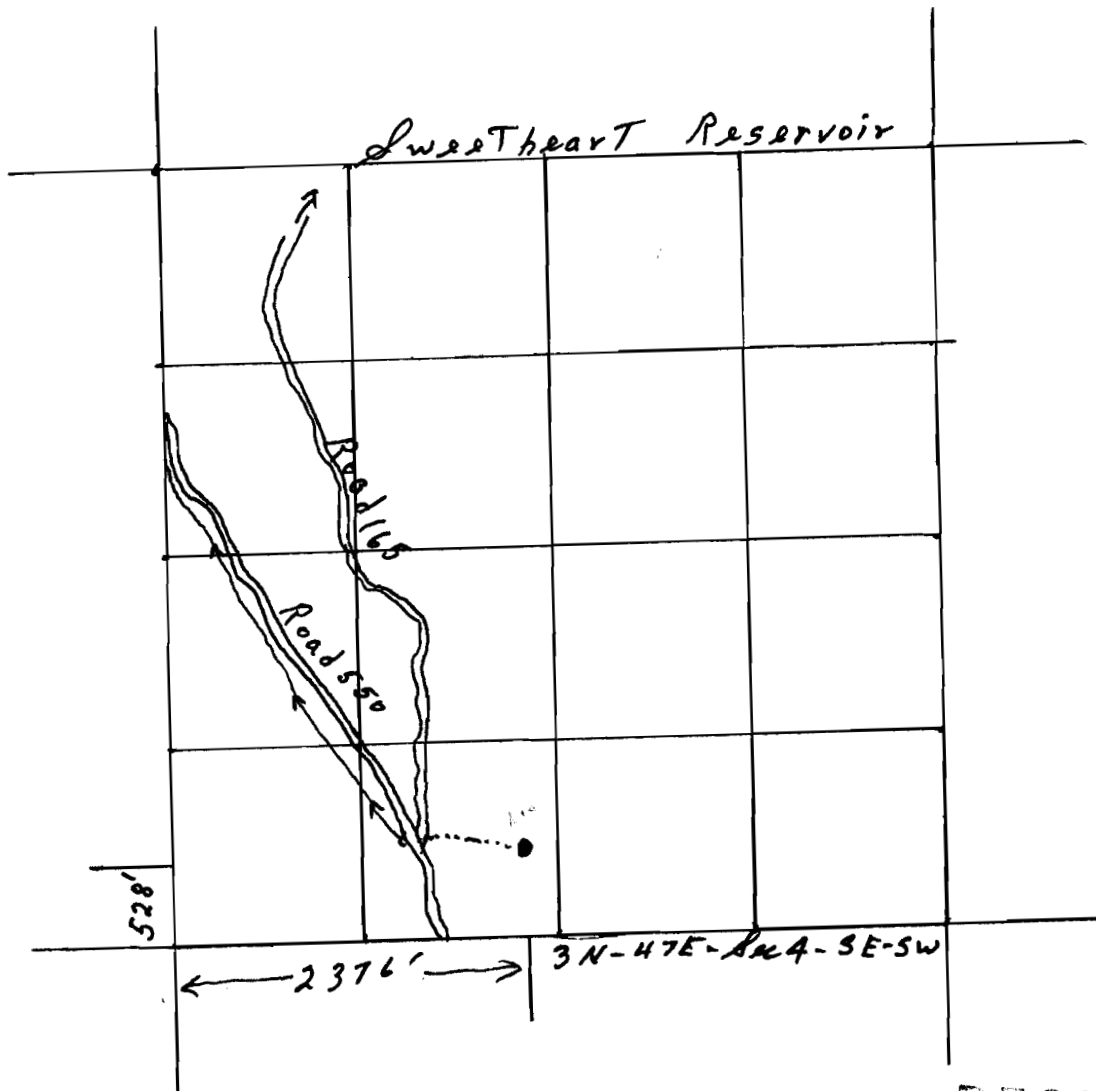

RECEIVED

AUG 19 1982

WATER RESOURCES DIV.
SALEM, OREGON

4 inches = 1 mile