
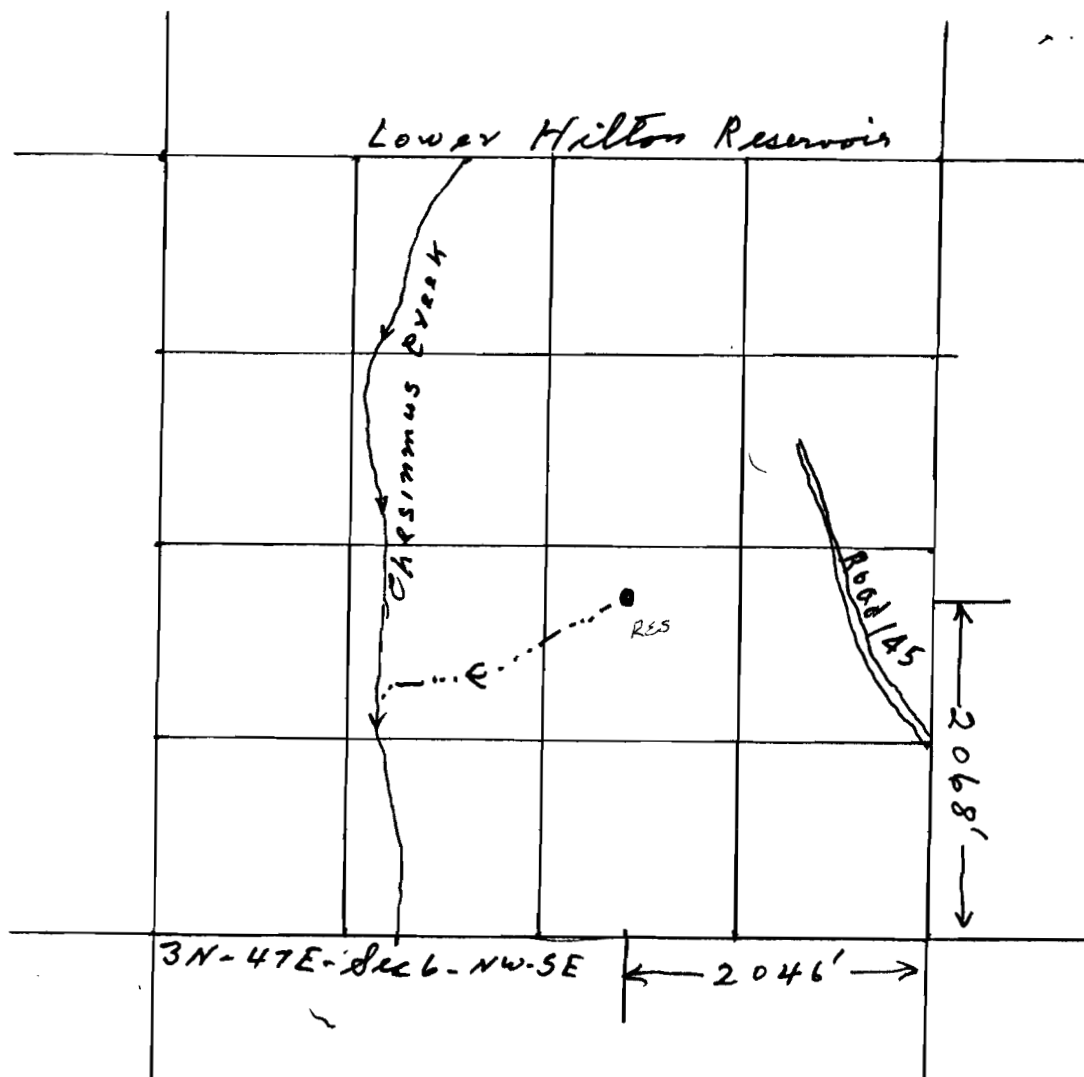


Application No. R63893
Permit No. R 9935

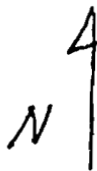

4 inches = 1 mile

RECEIVED

AUG 19 1982

WATER RESOURCES DIVISION
SALEM, OREGON