


Application No. R63894

Permit No. R 9936

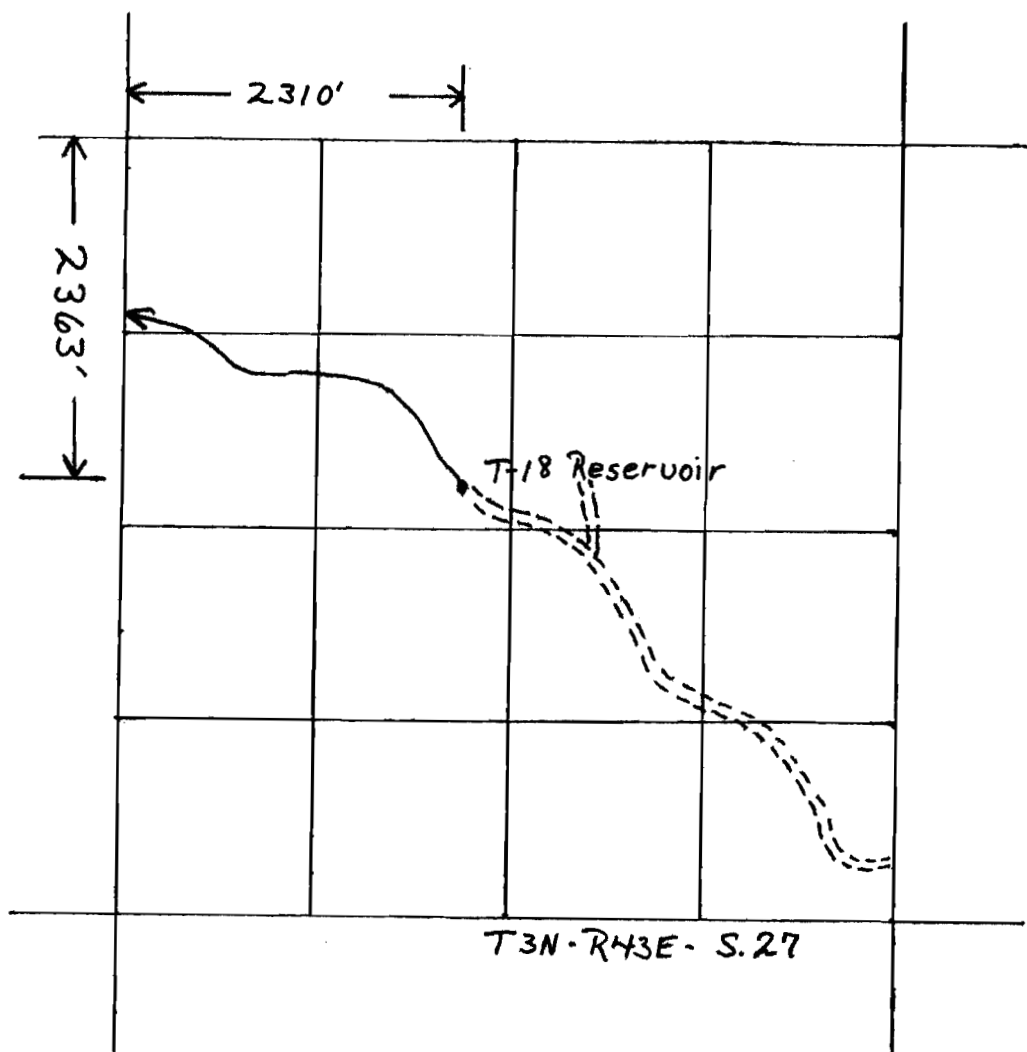

RECEIVED

AUG 19 1982

WATER RESOURCES DEPT.
SALEM, OREGON

4 inches = 1 mile