


Application No. R63896
Permit No. R 9938

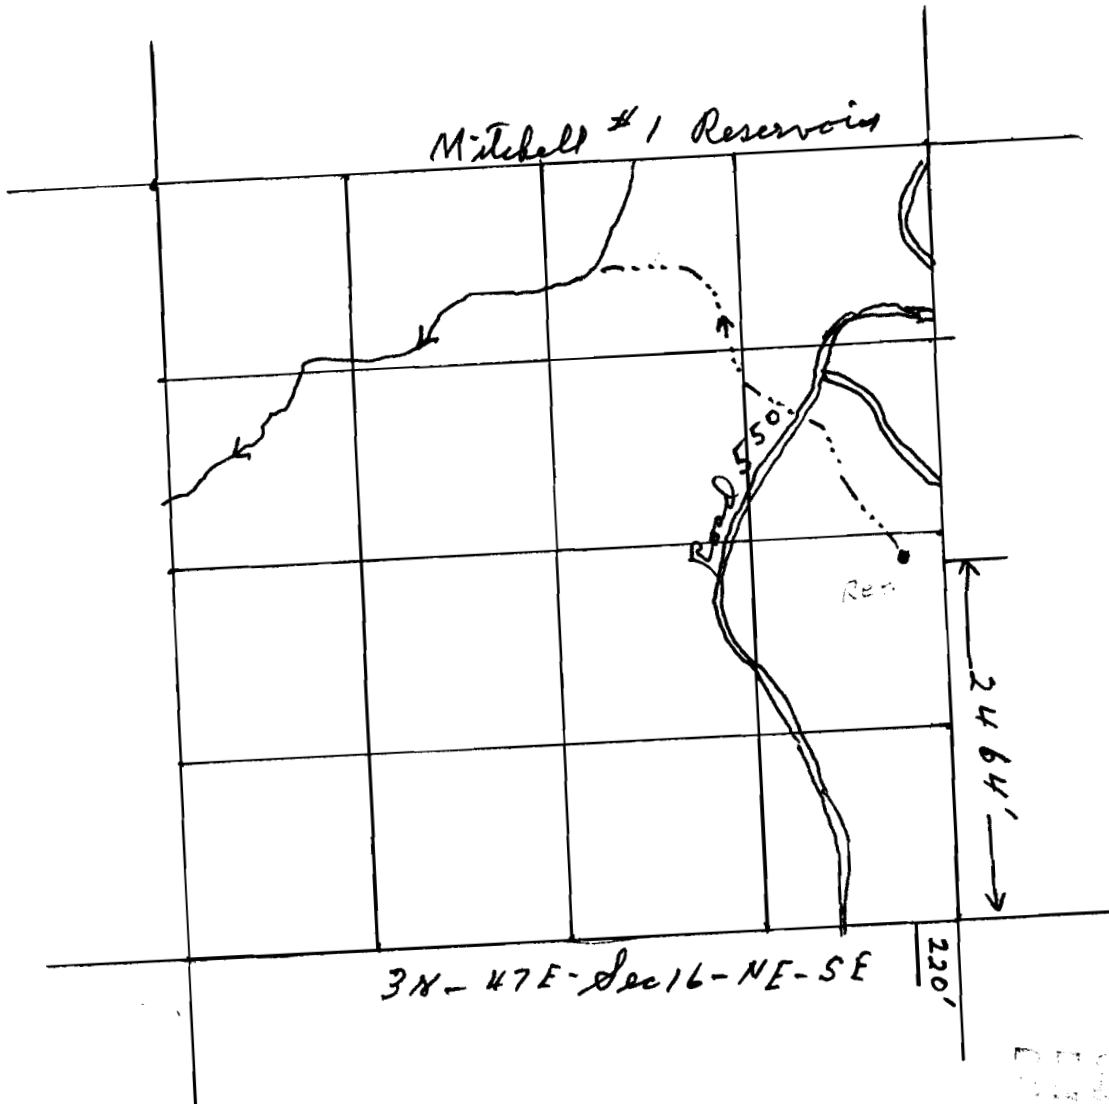

RECEIVED

AUG 19 1982

WATER SOURCE
SALEM, OREGON

4 inches = 1 mile