


Application No. R63897
Permit No. R 9939

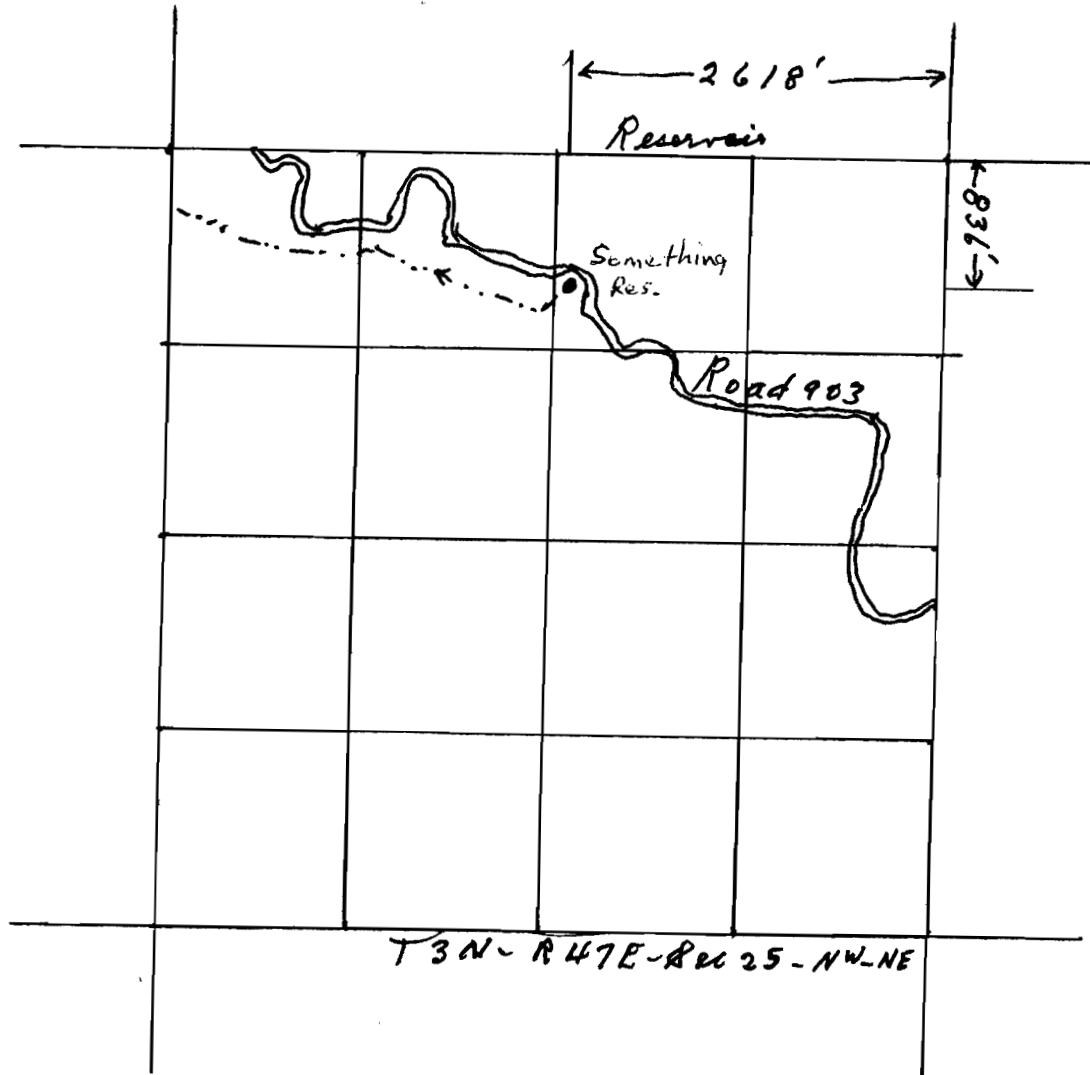

RECEIVED

AUG 19 1982

WATER COURSE
SALEM, OREGON

4 inches = 1 mile