


R-9982

Township 7.5 Range 4 Section 1

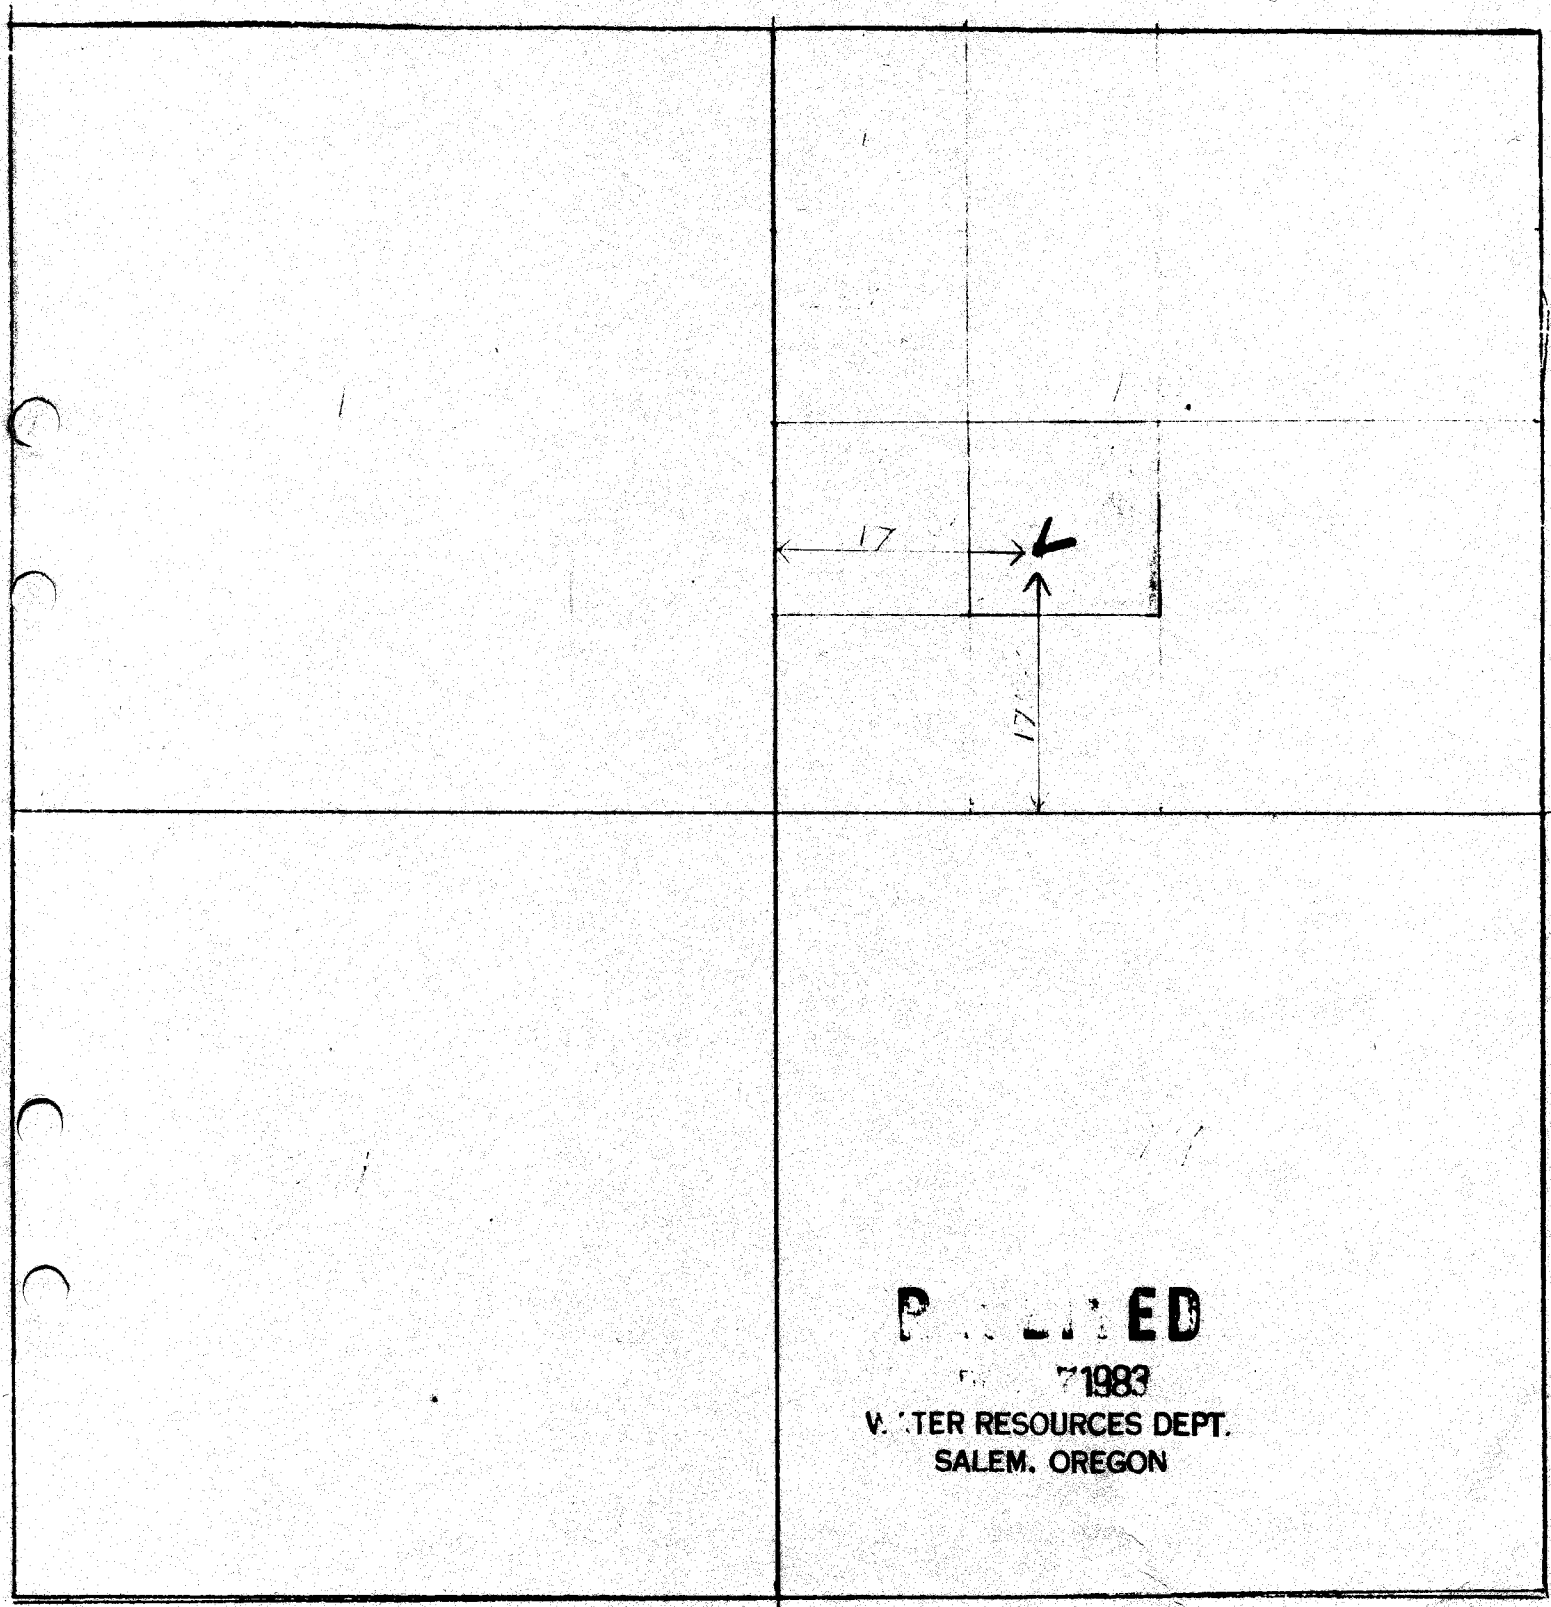

PAID

71983
WATER RESOURCES DEPT.
SALEM, OREGON

NAME 6 County

Application No. R-63648
Permit No. R 9982