


65
R 32E

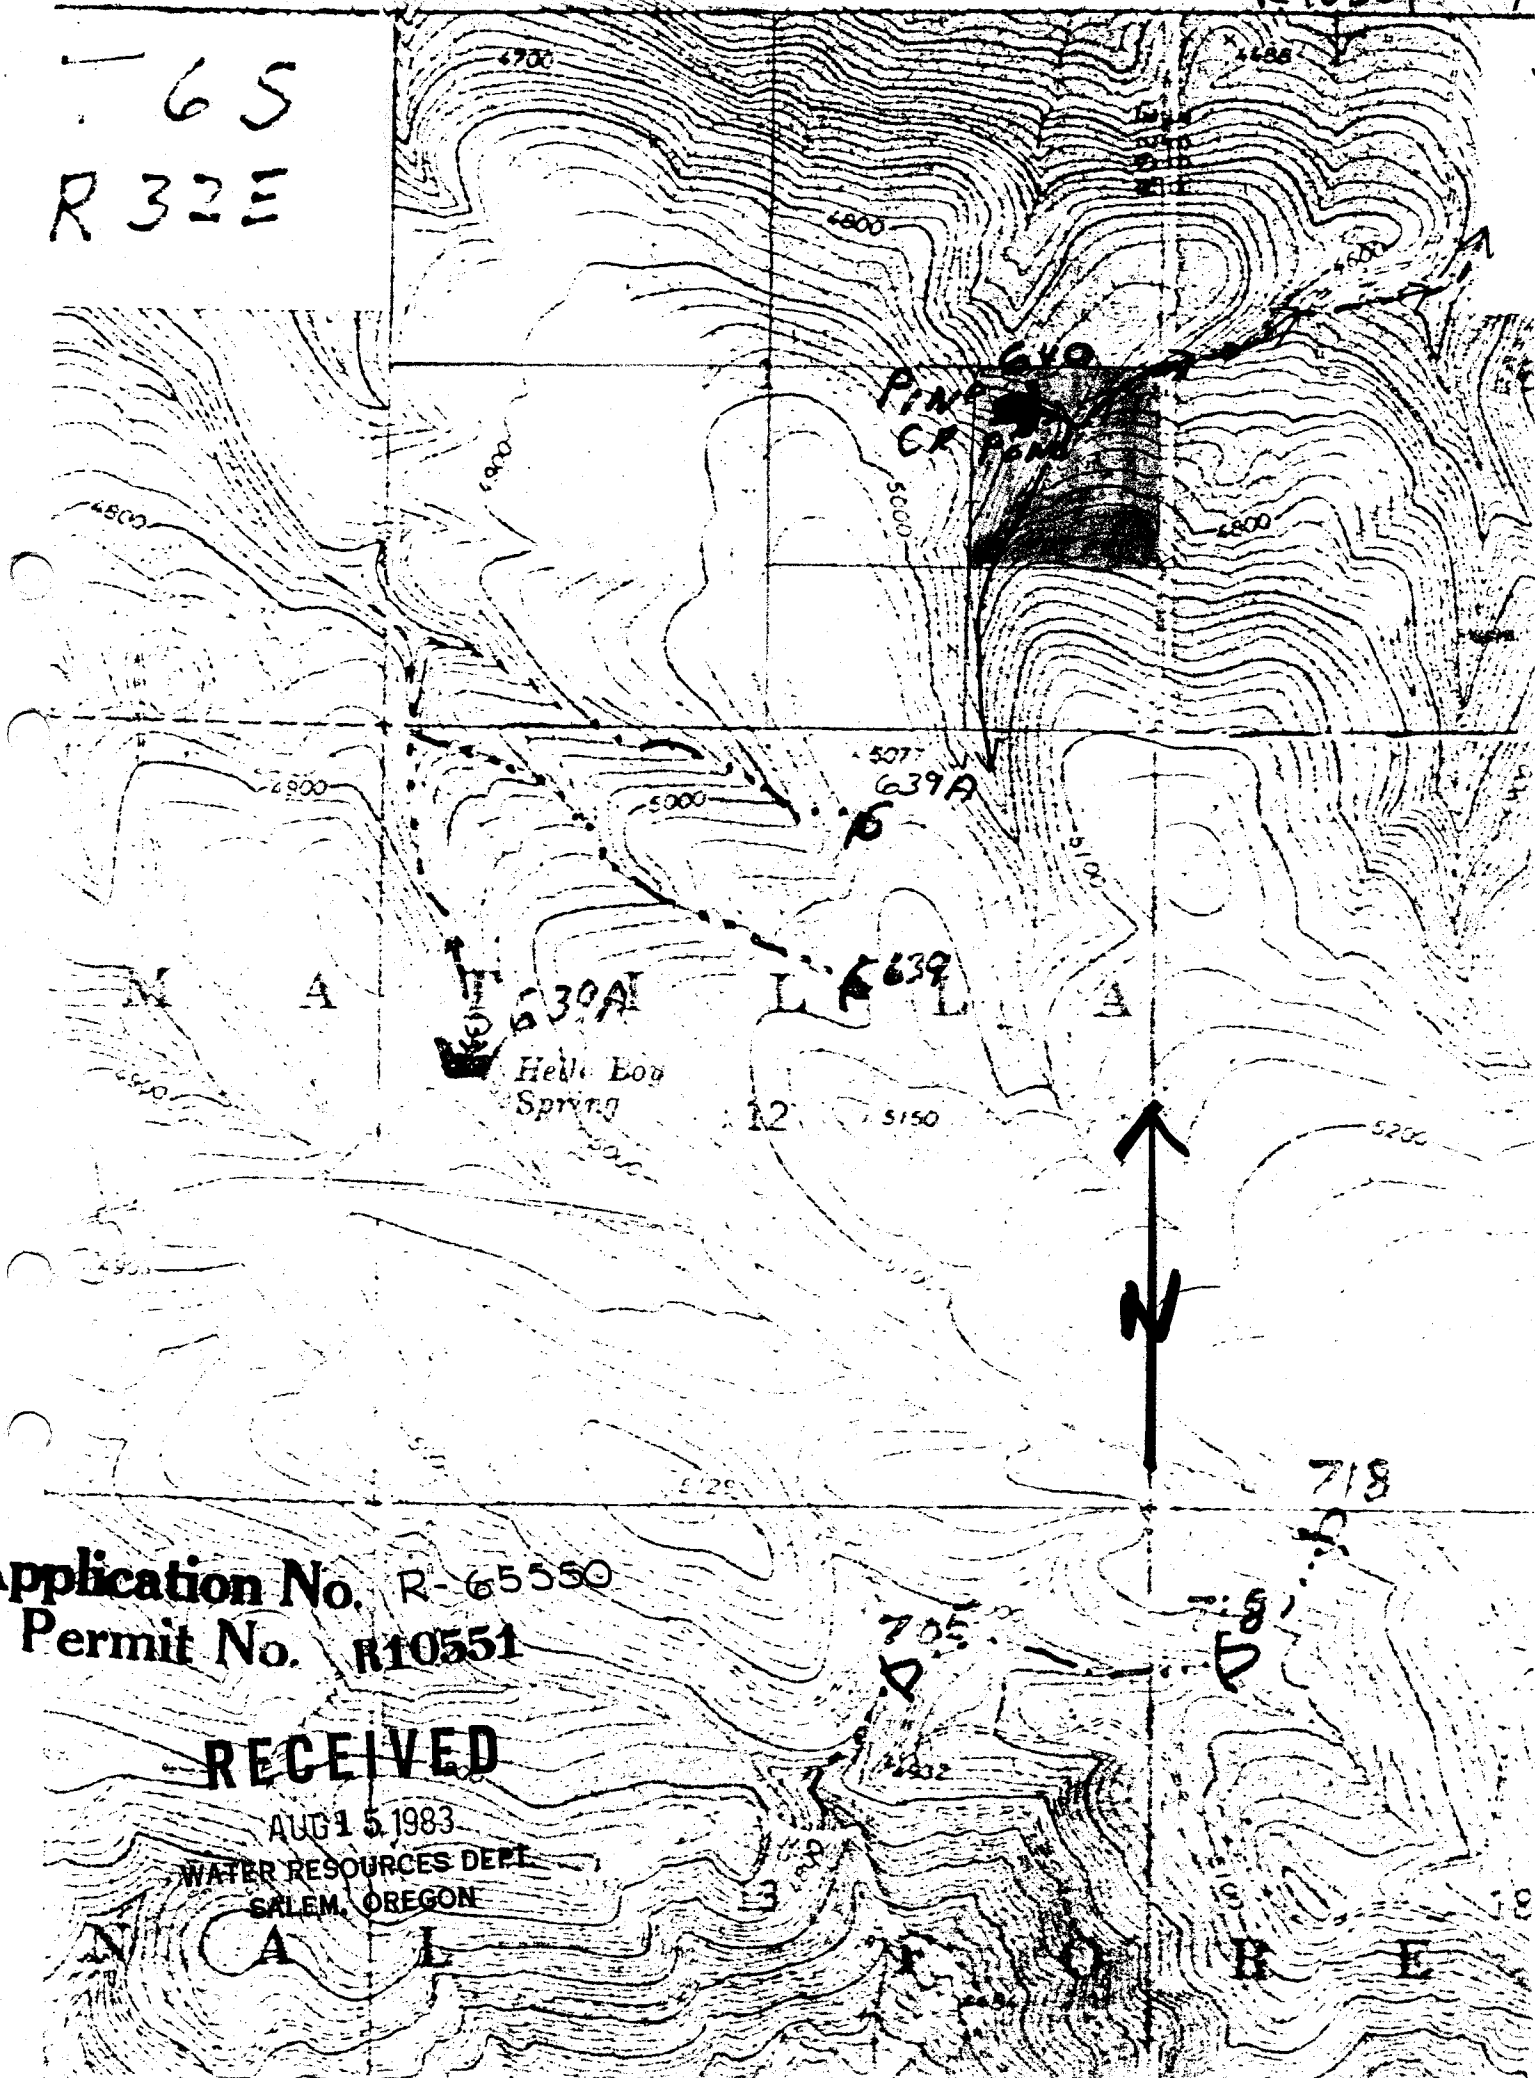

Application No. R-65550
Permit No. R10551

RECEIVED

AUG 15 1983
WATER RESOURCES DEPT.
SALEM, OREGON

N C A L F O R B E