


N ↑

RECEIVED

APR 29 1982
NATURAL RESOURCES DEPT.
SALEM, OREGON

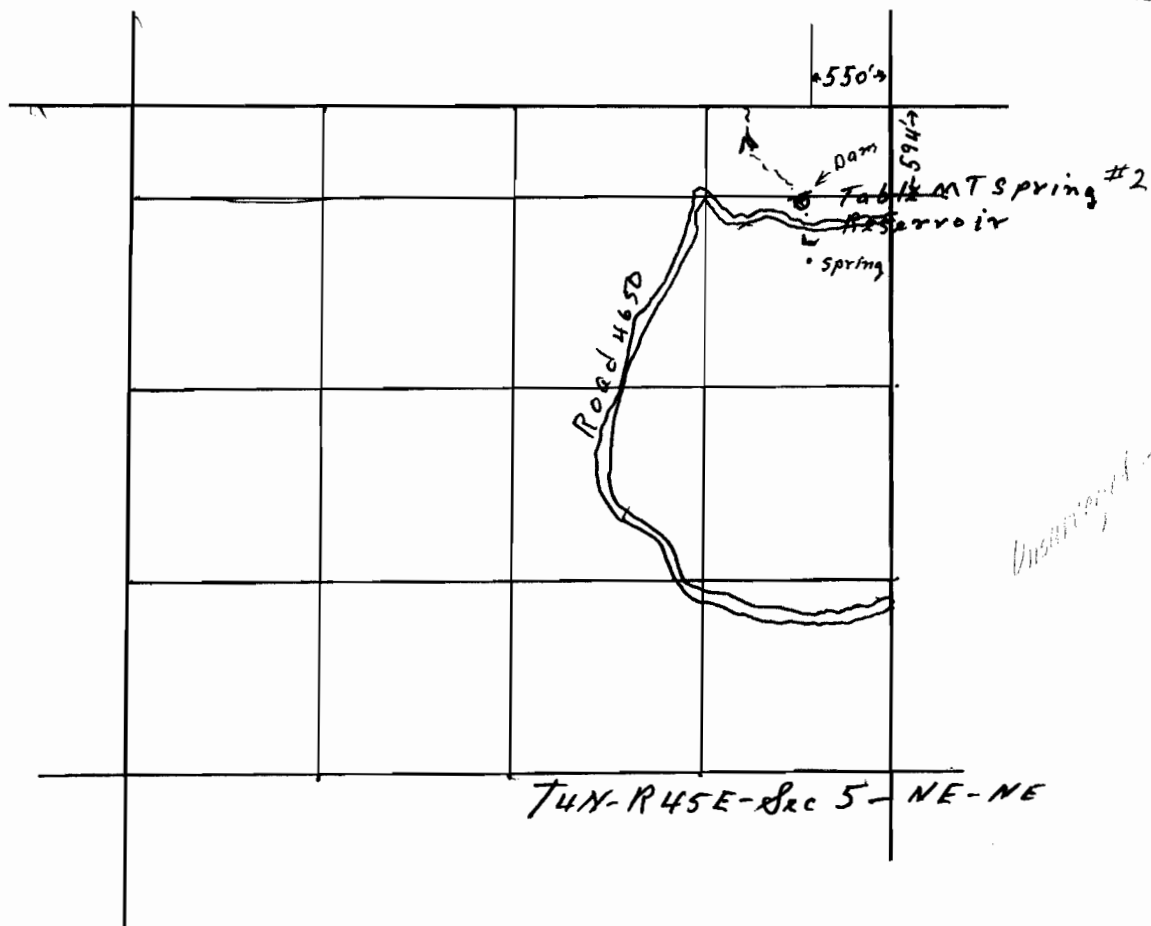

Unsurveyed - potential

Application No. R-65759

Permit No. R10739