


N

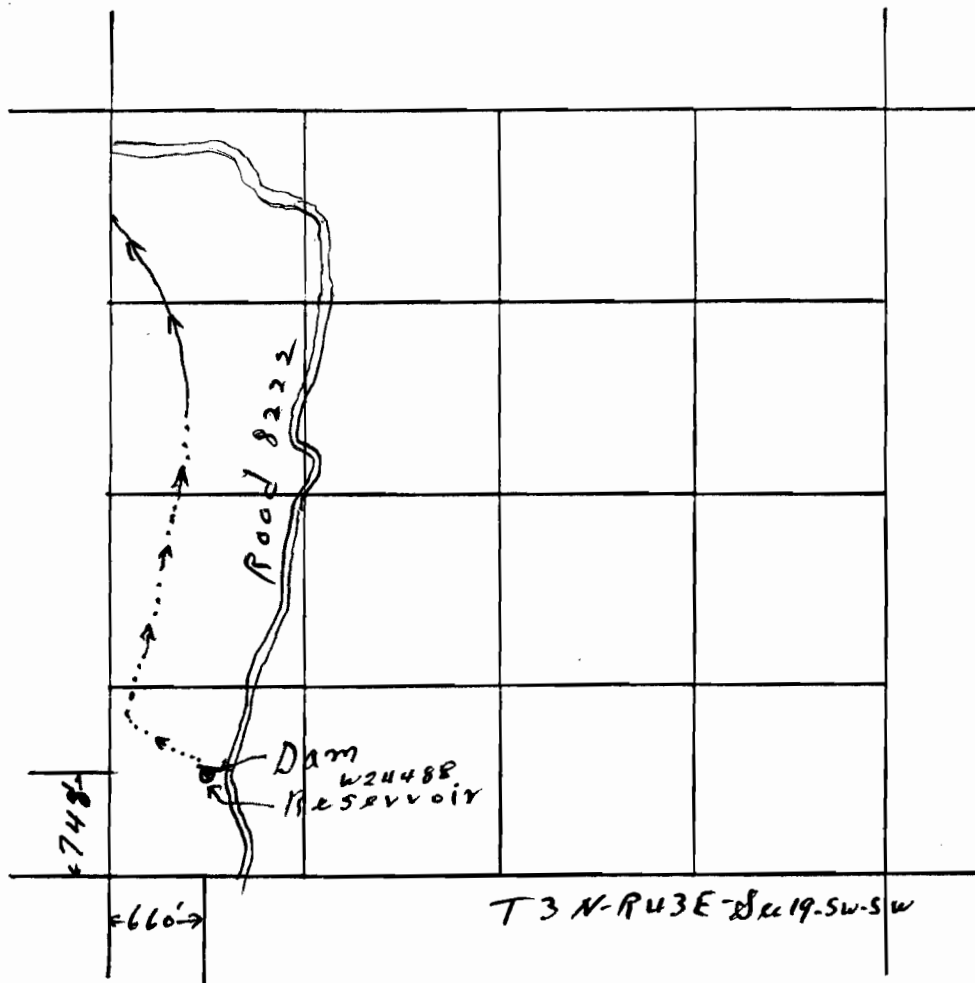

4 inches = 1 mile

Application No. ^{R-}65760
Permit No. R10740

RECEIVED
APR 30 1980
L&R RESOURCES DEPT.
SALEM, OREGON