


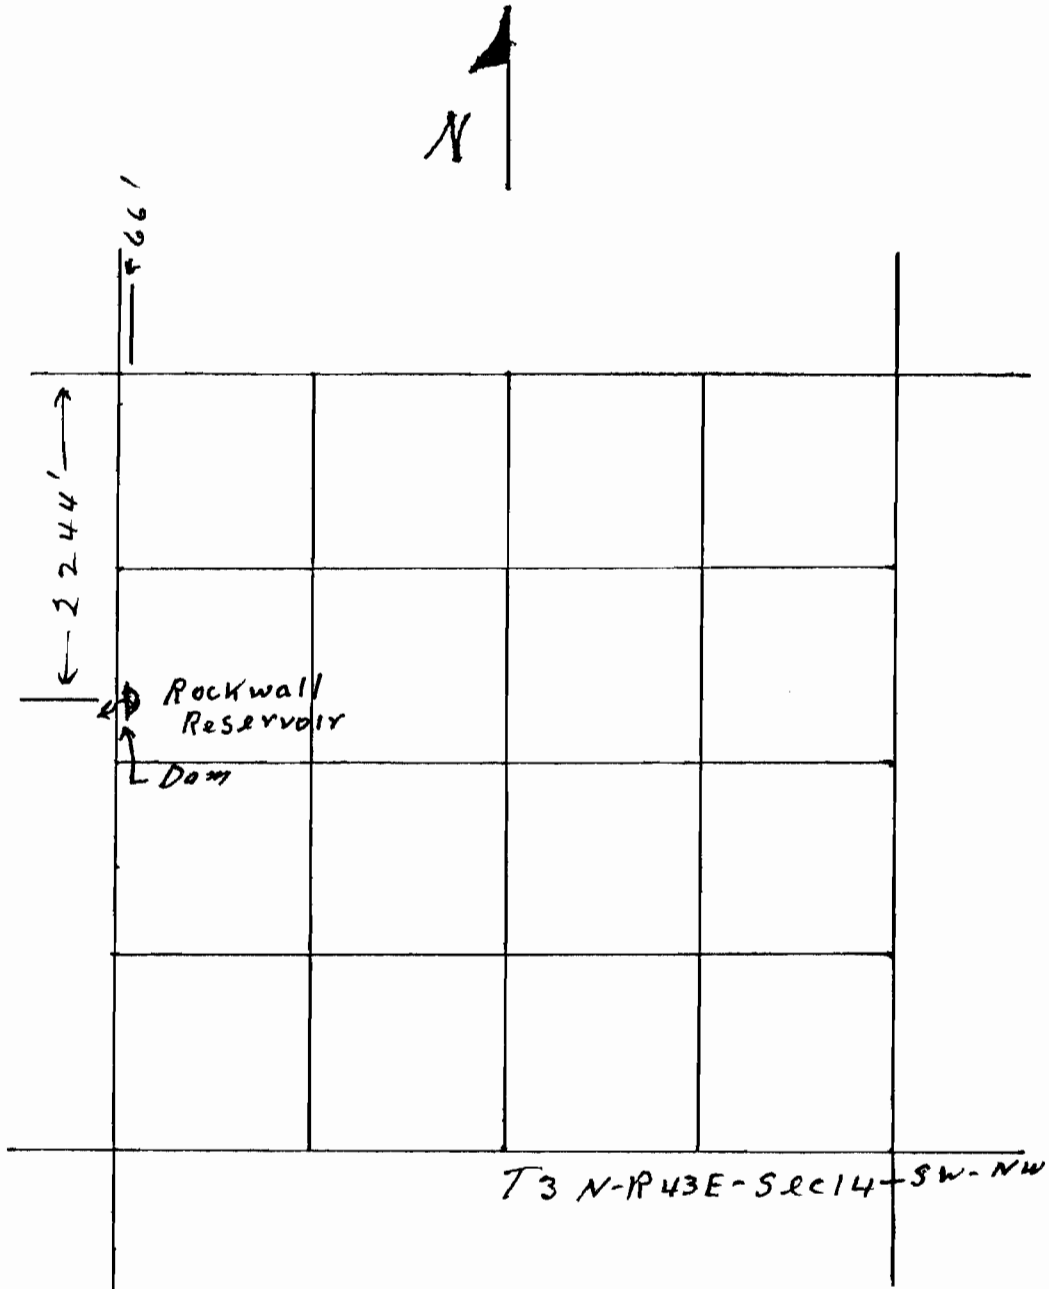

**RECEIVED**

APR 28 1967

LAND DIVISIONS DEPT  
SALEM, OREGON

4 inches = 1 mile

Application No. <sup>R-</sup>65761

Permit No. **R10741**