


N

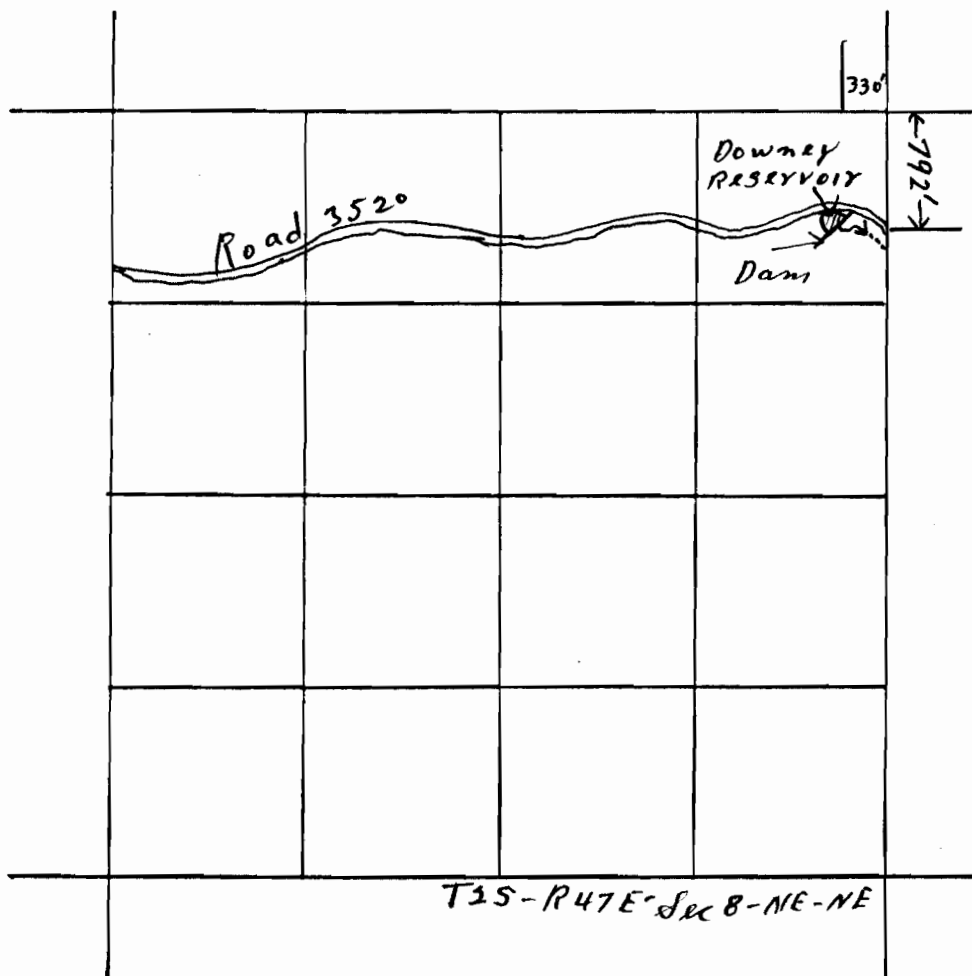

4 inches = 1 mile

R-

Application No. 65762

Permit No. R10742

RECEIVED

APR 29 1982

LAND RESOURCES DEPT.
SALEM, OREGON