


N

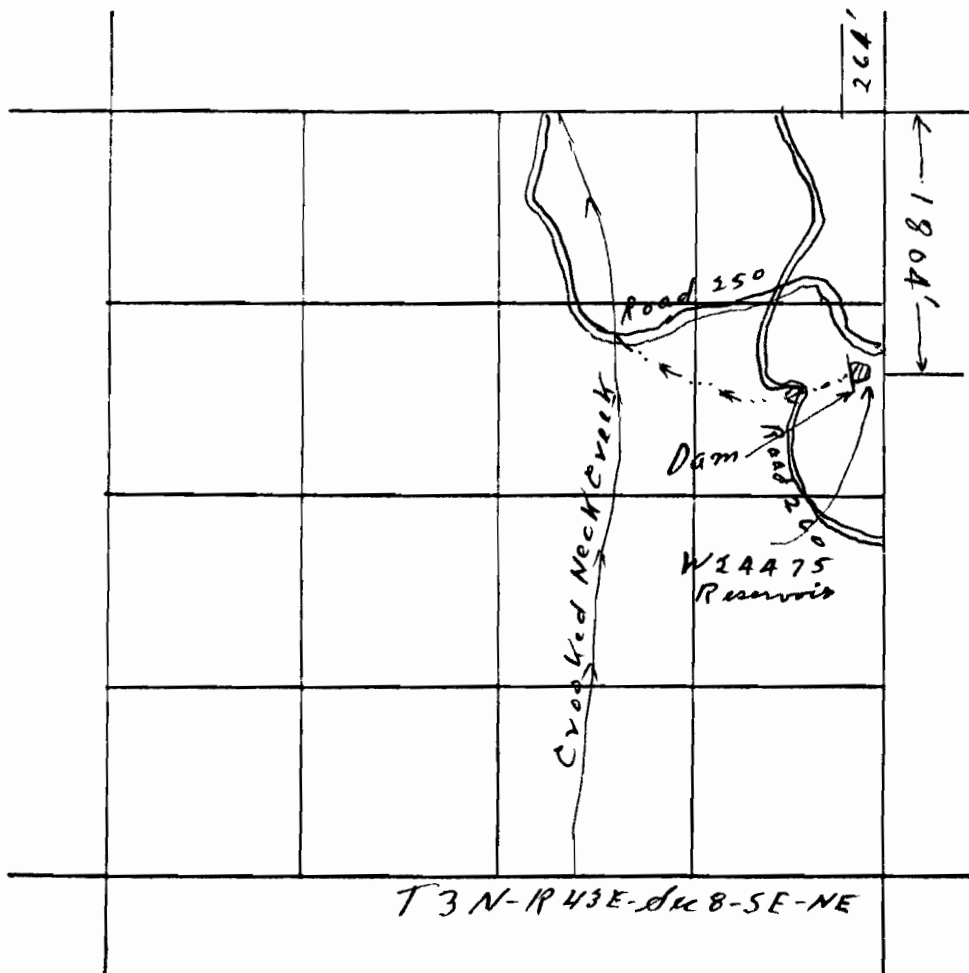

4 inches = 1 mile

Application No. ^{R-}65764
Permit No. R10744

RECEIVED

APR 29 1960

LAND RESOURCES DEPT
SALEM, OREGON