


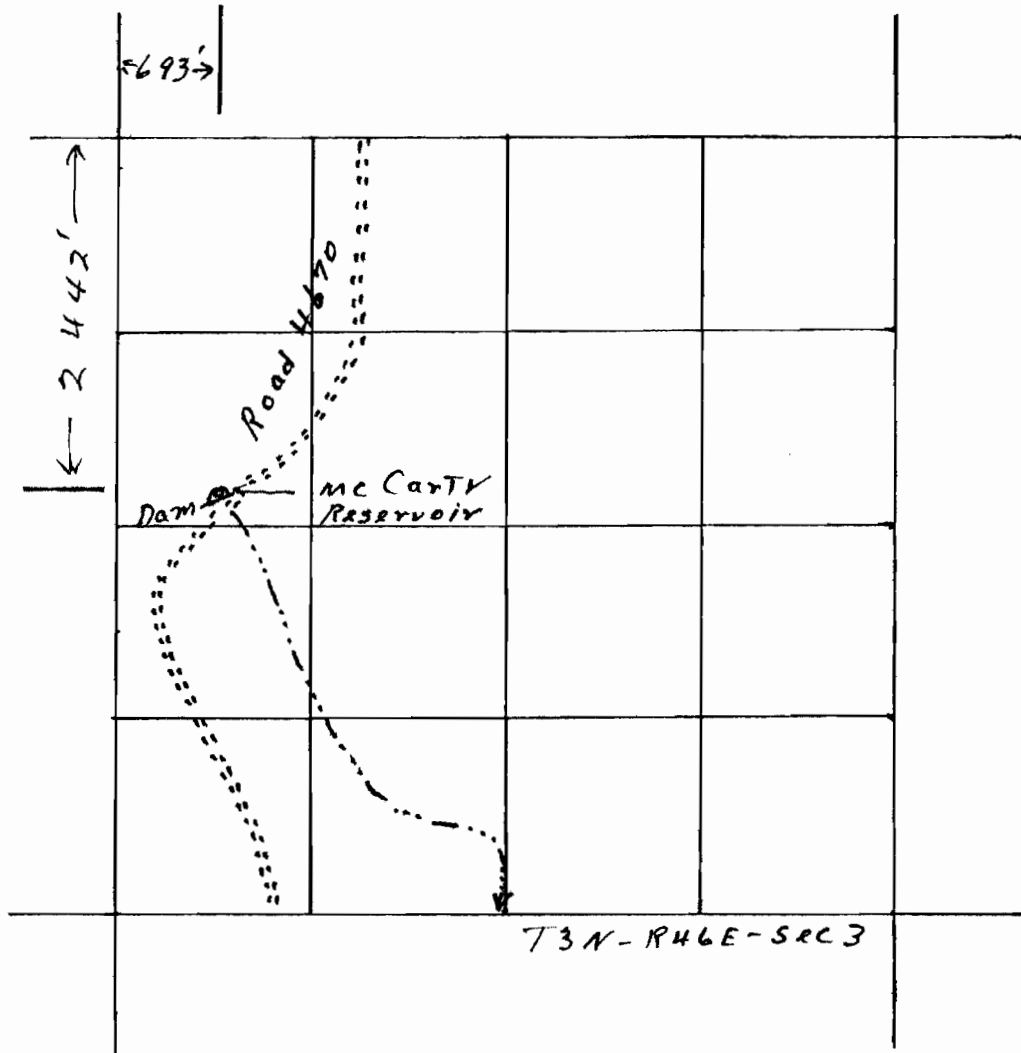

Application No. ^{R-}65765
Permit No. R10745

4 inches = 1 mile

RECEIVED
APR 29 1962
LAND RESOURCES DEPT
SALEM, OREGON