


N

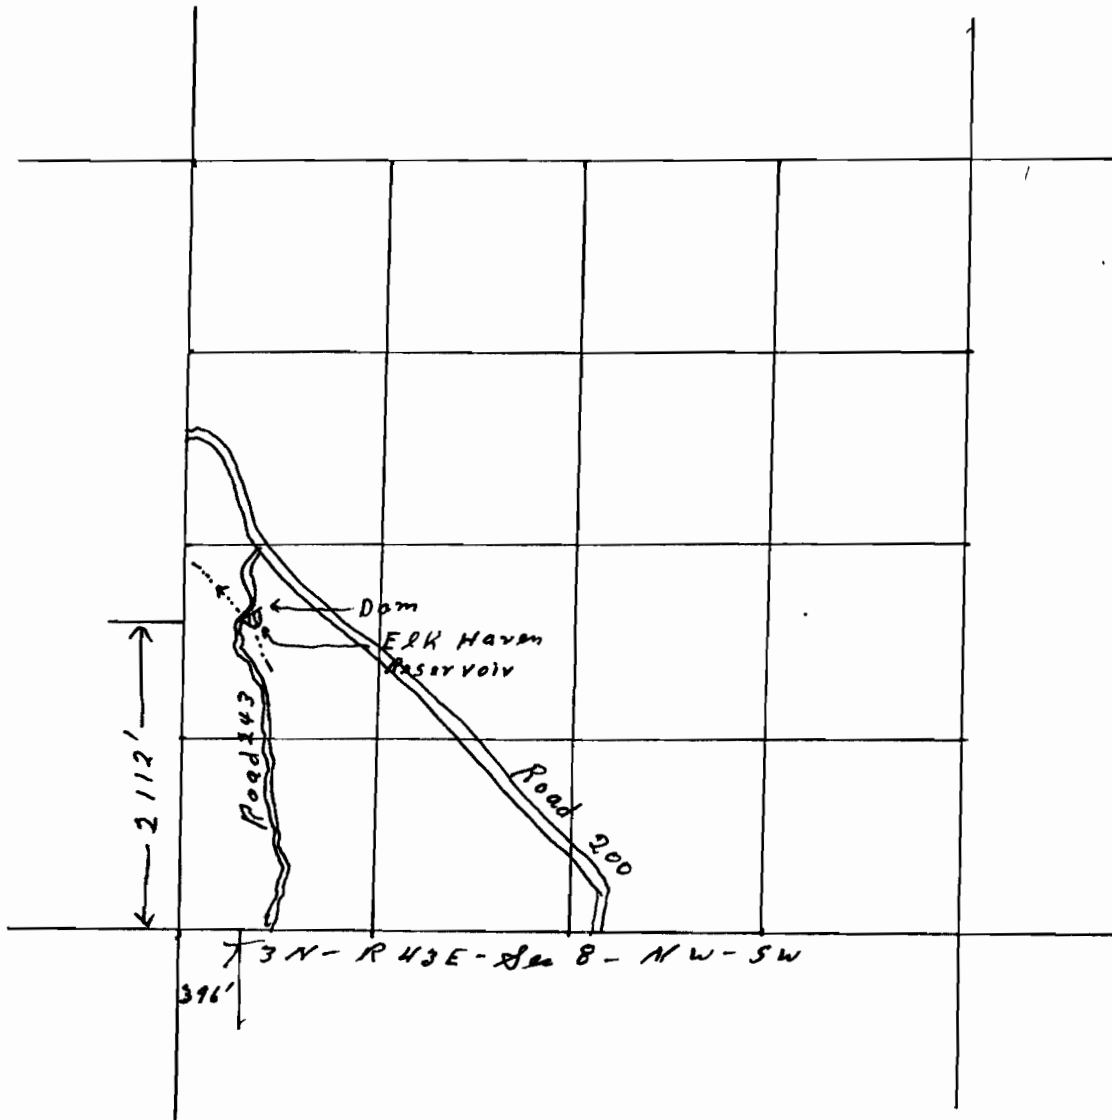

RECEIVED

APR 29 1962

LAND RESOURCES DEPT.
SALEM, OREGON

4 inches = 1 mile

Application No. R-65767

Permit No. R10747