
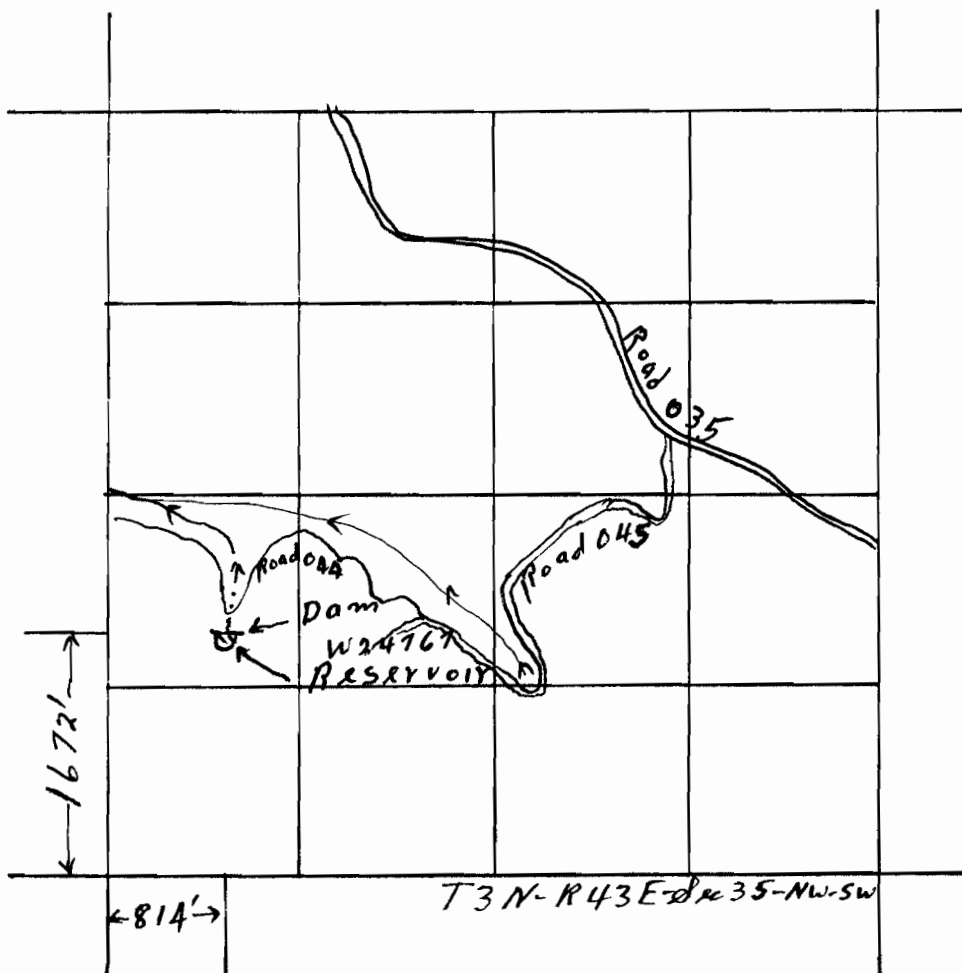


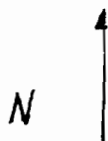

4 inches = 1 mile

Application No. R-65768  
Permit No. R10748

**RECEIVED**

APR 29 1982

FOREST SERVICE DEPT.  
SALEM, OREGON