


N ↑

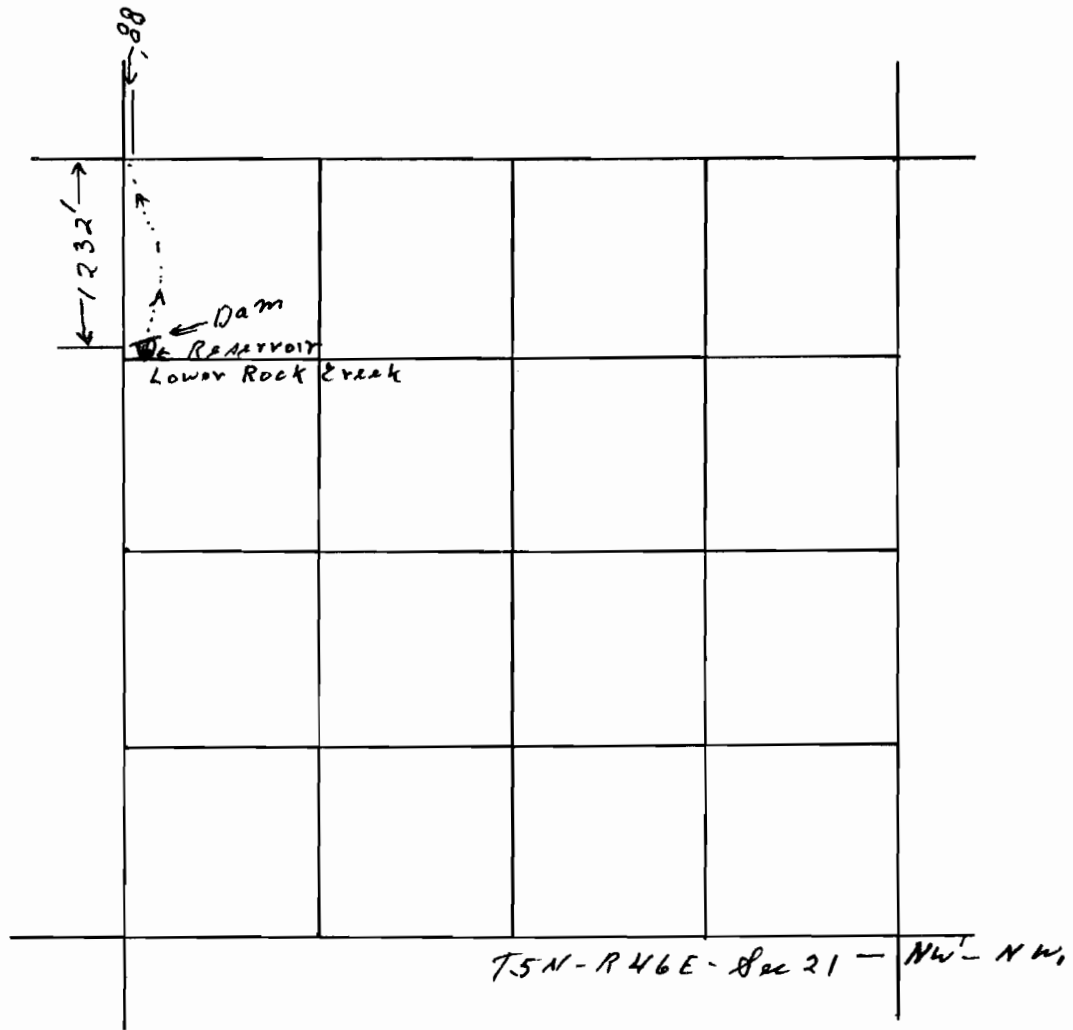

4 inches = 1 mile

Application No. R-65769

Permit No. R10749

PRINTED

APR 19 1912

LAND RESOURCES DEPT.
SALEM, OREGON