


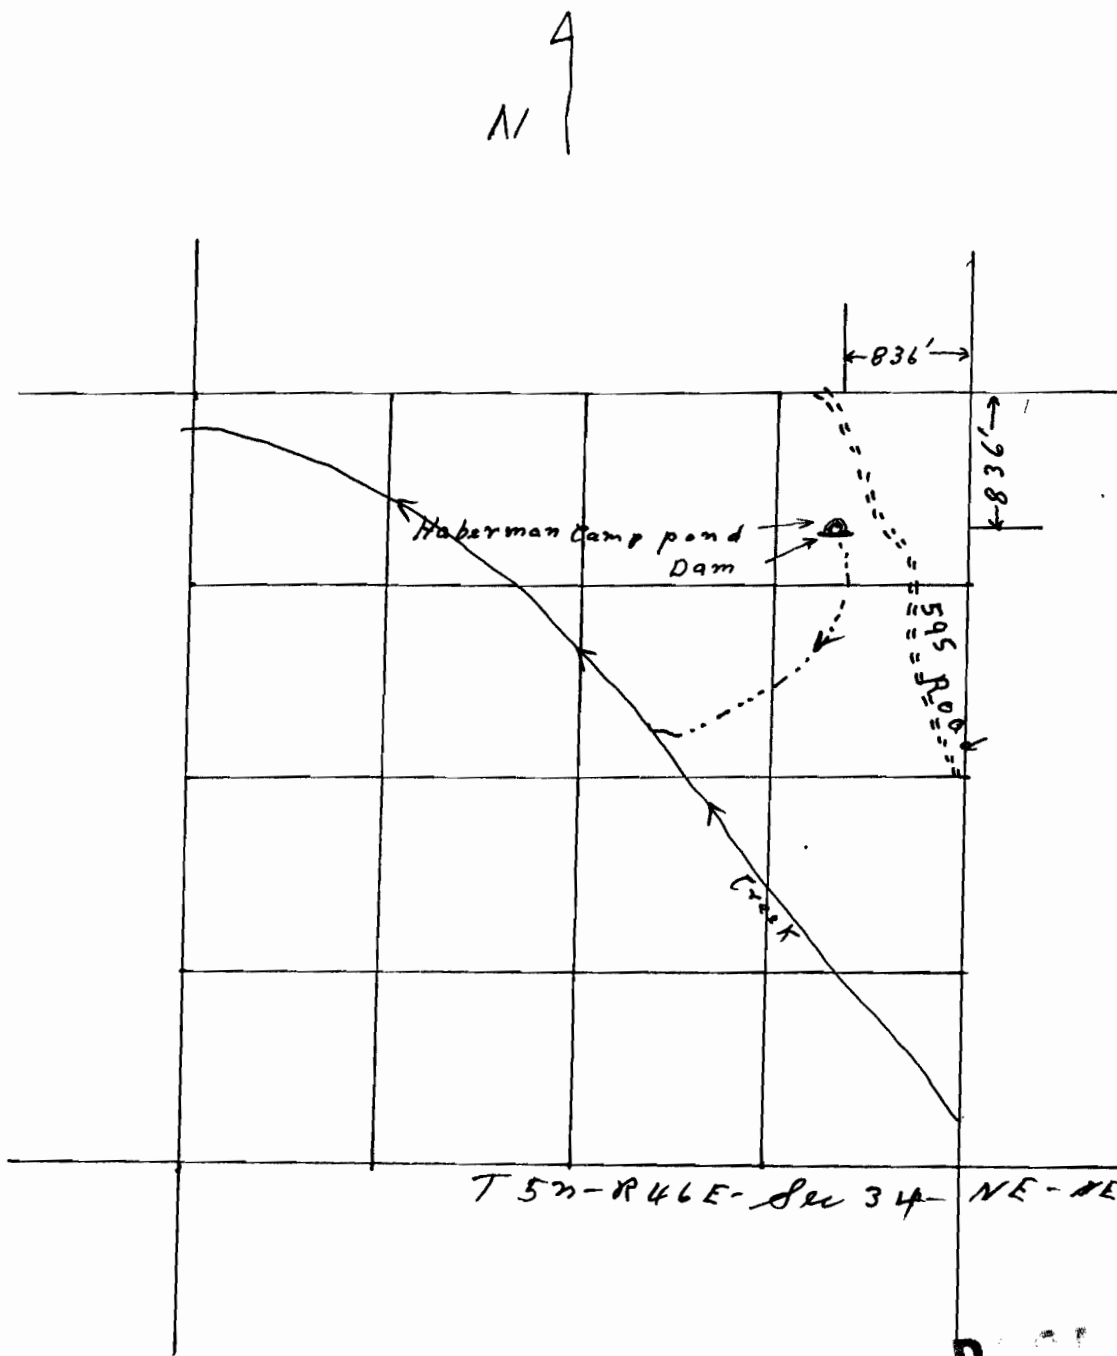

RECEIVED

AUG 19 1990
 LAND REL. DIV. DES. DEPT
 SALEM, OREGON

4 inches = 1 mile

Application No. R-65770

Permit No. R10750