


N ↑

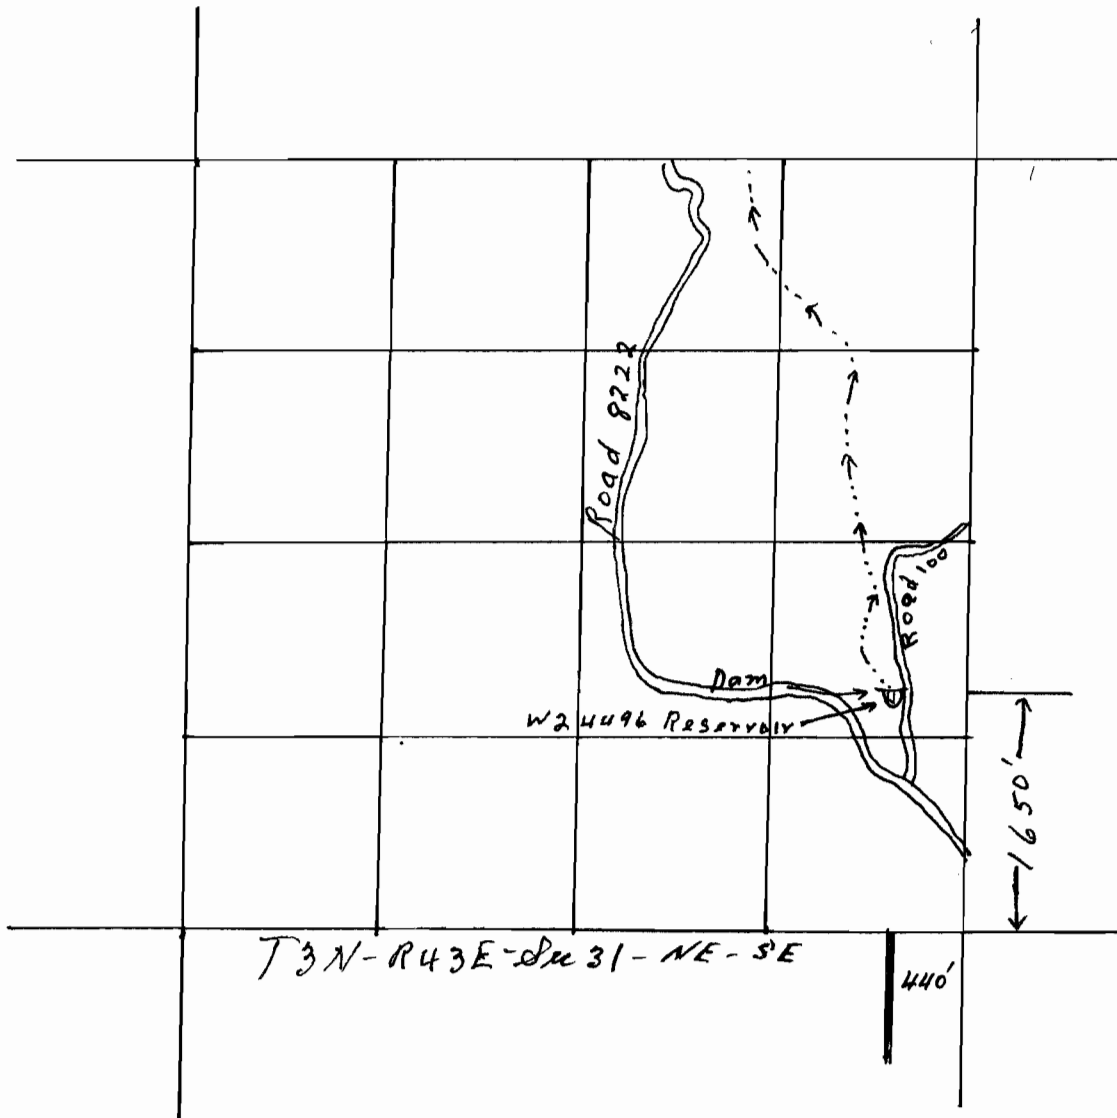

Application No. R-65772
Permit No. R10752

4 inches = 1 mile

RECEIVED

APR 19 1982
LAND RESOURCES DEPT
SALEM, OREGON