


N ↑

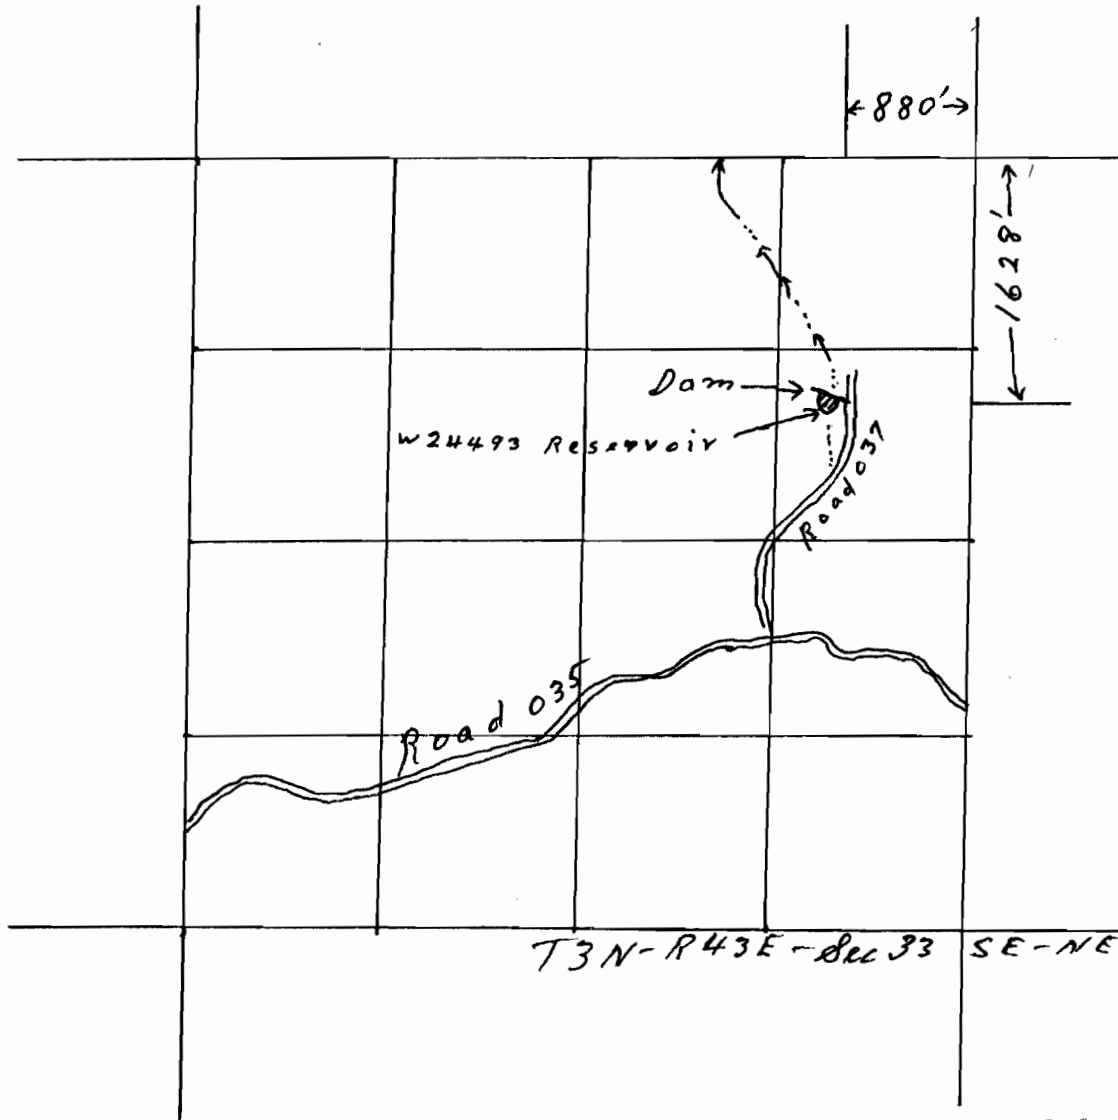

Application No. R-65773

Permit No. R10753

RECEIVED

APR 19 1983
LAND REVENUE DEPT
SALEM, OREGON

4 inches = 1 mile